IREDELL COUNTY HEALTH DEPARTMENT

Statesville Office (704) 878-5305 Mooresville Office (704) 660-3625 PERMIT # 211480

IMPROVEMENT PERMIT / AUTHORIZATION TO CONSTRUCT / OPERATION PERMIT / EXISTING SYSTEM

PIN # 4657-69-5137

APPLICANT: RENE GONZALEZ APPLICANT ADDRESS: 159 KETCHIE RD

SITE ADDRESS: SAME PHONE: ALT. PHONE:

SITE DIRECTIONS: 21, RHINEHARD, KETCHIE, ON L

SUBDIVISION: SUNSHINE ESTATES SECTION: LOT # 31 LOT AREA: .85 AC DESIGN FLOW: L.T.A.R.:

Septic Tank (gal) STB Date
Pump Tank (gal) PT Date
Pump Make EXISTING Model Serial #
Nitrification Fields # Lines Linear Ft:
Trench Width Max. Trench Bottom Depth Gravel Depth 12"

☐ New System ☐ Repair ☐ Expansion System Type: I (II) III IV V VI
System Description: GRAVEL
Repair System Description:
Maintenance Agreement Required: ☐ YES ☒ NO
☒ GRAVITY ☐ PRESSURE


☐ Residence No. Bedrooms
☐ Business No. Persons
☒ Other No. Employees
☐ Slab ☐ Crawl Space
☐ Basement w/plumbing ☐ Basement w/o plumbing

Water Supply: ☒ Private ☐ Public ☐ Community


Comments / Conditions: NOT RECOMMENDED TO DRIVE OVER DRAIN FIELD

GARAGE

INITIAL SITE SKETCH

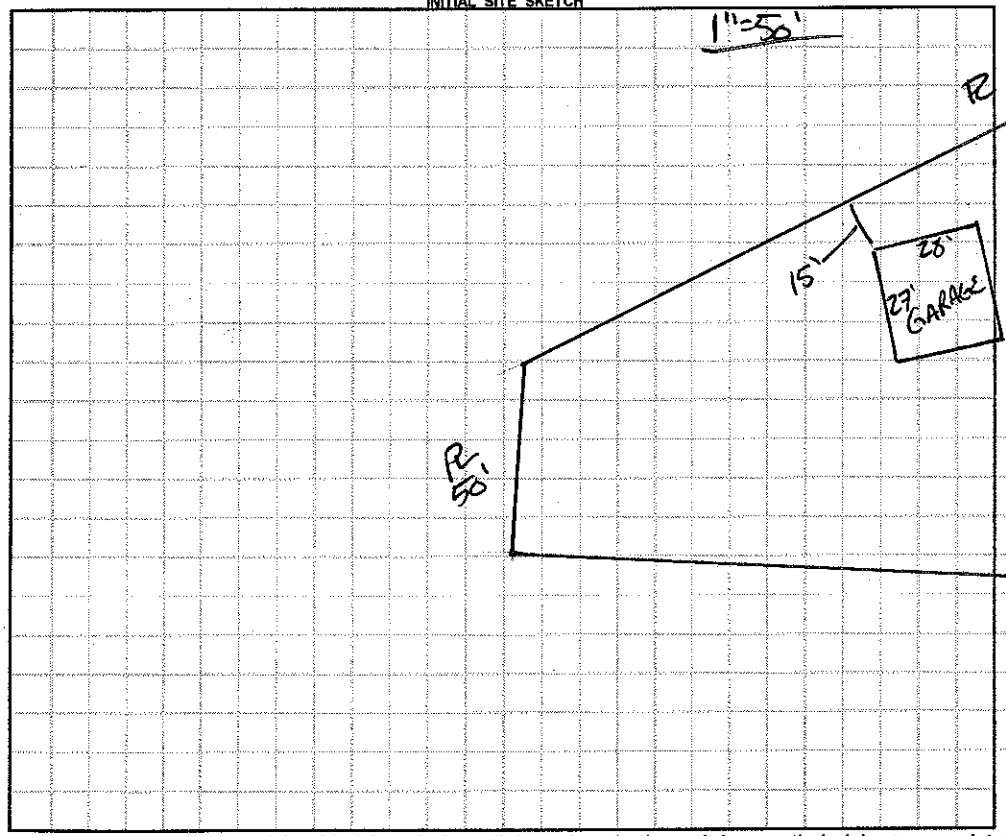

AS BUILT SKETCH

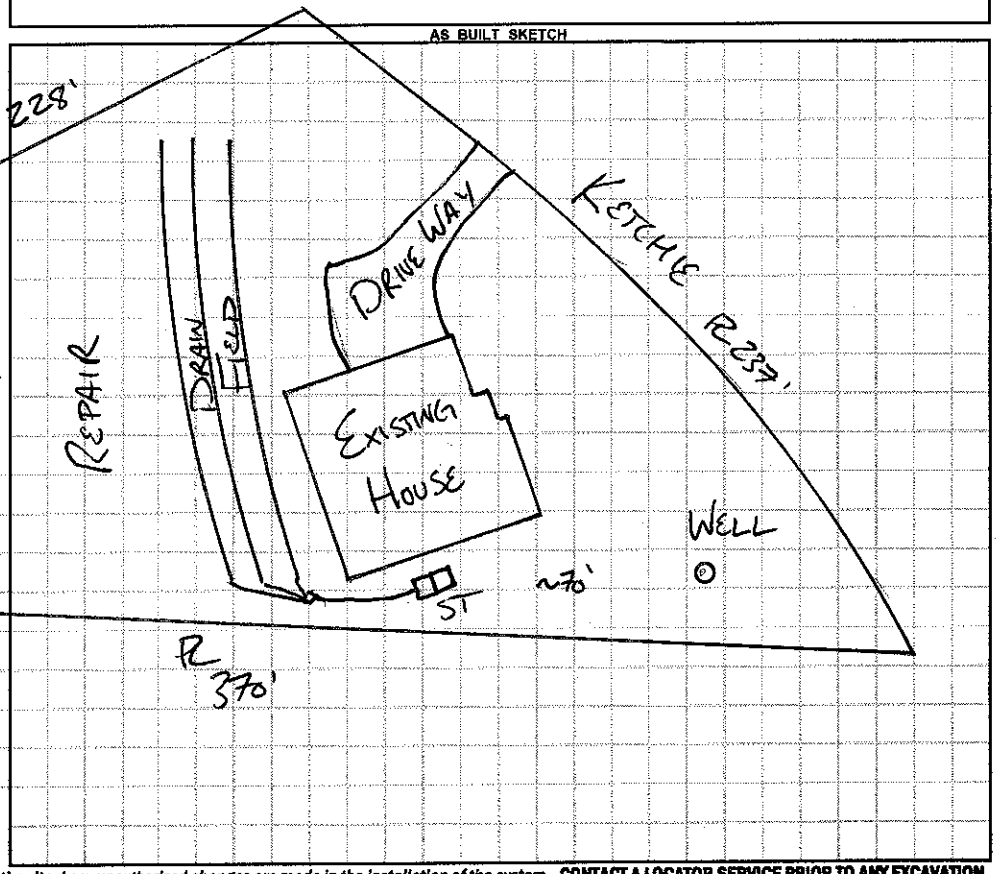

Permit can be suspended or revoked if any false information is supplied toward securing the permit / any unauthorized changes are made to the site / any unauthorized changes are made in the installation of the system. **CONTACT A LOCATOR SERVICE PRIOR TO ANY EXCAVATION**

☐ **IMPROVEMENT PERMIT** *with plat valid without expiration.* ☐ **IMPROVEMENT PERMIT** *with site plan valid for 60 mos.* ☐ **AUTHORIZATION TO CONSTRUCT** *valid for period equal to IMPROVEMENT PERMIT--not to exceed 60 mo.*

Owner / Applicant Signature: Date: 7-2-15 Installed by:

IMPROVEMENT PERMIT by: Date: OPERATION PERMIT by: Date:

AUTHORIZATION TO CONSTRUCT by: Date: Existing System Inspected by: APPROVED Date: JUN 26 2015

Health Dept. Copy - WHITE Applicant (Final Approval) - YELLOW Applicant (Conditional Approval) - PINK