IREDELL COUNTY HEALTH DEPARTMENT

IMPROVEMENT PERMIT / CERTIFICATE OF COMPLETION / OPERATION PERMIT / EXISTING SYSTEM INSPECTION

STATESVILLE 704-878-5305 MOORESVILLE 704-664-5281

PROPERTY DESCRIPTION NO. 2887 DATE 8/8/94

OWNER OR CONTRACTOR Broadmoor Homes TAX MAP NO. IM16 B21 4657695558 Watershed: ☐ Yes ☑ No

ADDRESS Po Box 1242 Mooresville PHONE: Business 663-7600 Home

LOCATION Rinehart Rd off 150E, TL Ketchie Dr. to lot on ® behind Sunshine Estates sign. #150 Ketchie Dr

SUBDIVISION Sunshine Est. BLOCK / SECTION LOT 21 LOT AREA ~ 1 AC SITE CLASS. P DESIGN FLOW 360 L.T.A.R. .25-.3

Septic Tank: 1000 Gallons; STB 825 Date 1/5/95

Pump Tank: Gallons; PT Date

Pump Make: Model Serial No.

Nitrification Field: No Fields 1 Square Feet 1200 Linear Feet 400

No Lines 4 Trench Width 36" Max Trench Bottom Depth 30" Gravel Depth 12"

☑ New System ☐ Repair System Type: ☑ I ☐ III, IV, V, VI

System Description: Conv-Drop Boxes

Repair System Description:

Maintenance Agreement Required: ☐ Yes ☑ No 1/2

☑ House/Mod. Home No. Bedrooms 3

☐ Mobile Home No. Bathrooms 2

☐ Business No. Employees

☐ Other

☐ Slab ☐ Crawl Space ☑ Basement w/plumbing ☐ Basement wo/plumbing

Water Supply: ☑ Individual ☐ Community ☐ Public


Comments:

Trenches No DEEPER THAN 30" on upper side of each trench. Gutters piped off chain field area. Diversion ditch must be completed for Completion

Comments:

Installed as shown

INITIAL SITE SKETCH

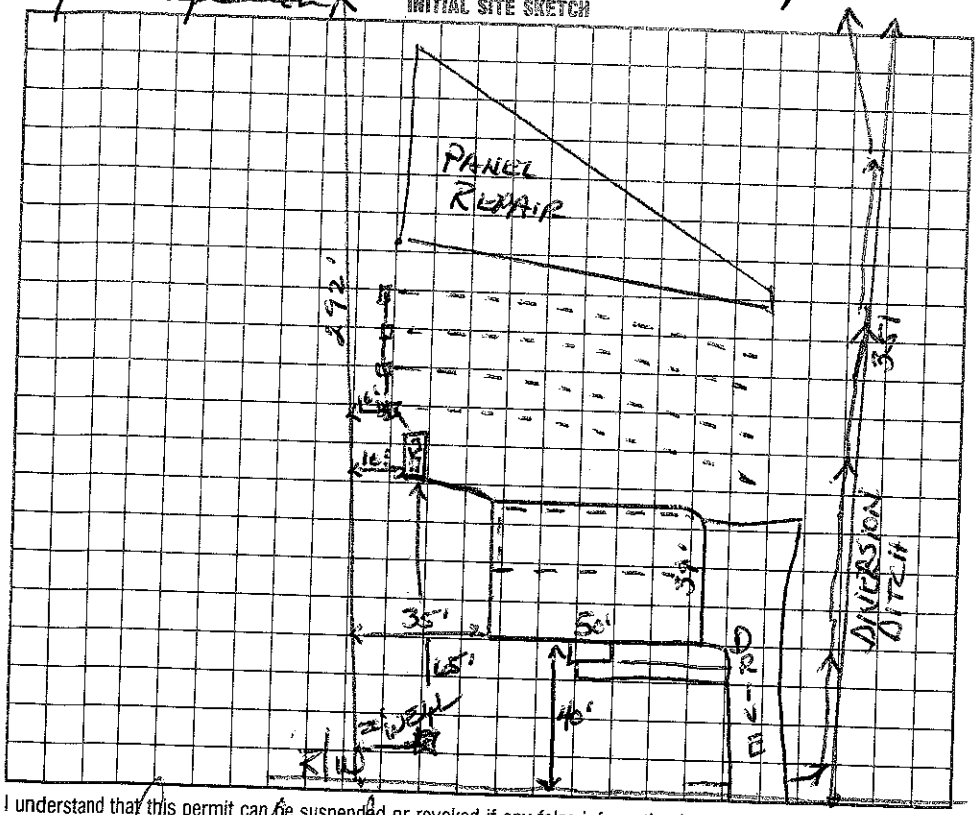

AS BUILT SKETCH

I understand that this permit can be suspended or revoked if any false information is supplied toward securing the permit/any unauthorized changes are made to the site/any unauthorized changes are made in the installation of the system. Improvement Permit is valid for 60 months from date of issuance. KETCHIEDR

Signed: Paul Broadmoor

Improvement Permit by: Wesley Sparks RS. date 8/8/94

Existing System Inspection by: date

Installed by: Curt Dunning

Certificate of Completion by: Wesley Sparks RS. date 2/9/95

Operation Permit by: date

HEALTH DEPT. COPY: WHITE INSPECTION COPY (FINAL): GREEN OWNER COPY (FINAL): YELLOW INSPECTION COPY (INITIAL): PINK OWNER COPY (INITIAL): GOLD