IREDELL COUNTY HEALTH DEPARTMENT

STATESVILLE 704-878-5305 MOORESVILLE 704-664-5281

IMPROVEMENT PERMIT / CERTIFICATE OF COMPLETION / OPERATION PERMIT / EXISTING SYSTEM INSPECTION

PROPERTY DESCRIPTION NO. 2381 DATE 7/28/93

OWNER OR CONTRACTOR MIKE KRAVITZ TAX MAP NO. 1M 16 A 30

ADDRESS KETCHIE ACRES - RINEHART RD. PHONE: Business 4651-69-6287 Home

LOCATION RINEHART RD.

SUBDIVISION KETCHIE ACRES BLOCK / SECTION 1 LOT 30 LOT AREA > 20,000 FT² SITE CLASS. P L.T.A.R. .25 - .3

Water Supply: ☑ Individual ☐ Community ☐ Public

Septic Tank: 1000 Gallons; STB 825 RST Date 7-3-93

Pump Tank: ____ Gallons; PT ____ Date ____

Nitrification Field: No Fields 1 Square Feet 1200 Linear Feet 400

No Lines 5 Trench Width 3' Trench Depth 32" Gravel Depth 12"

☑ New System ☐ Repair System Type: I, II, IV, V, VI

System Description: CONV - GRAVITY

Repair System Description: PRES PANEL

Maintenance Agreement Required: ☐ Yes ☑ No

☑ House/Mod. Home No. Bedrooms 3

☐ Mobile Home No. Bathrooms 2

☐ Business No. Employees ____

☐ Other ____

☐ Slab ☑ Crawl Space ☐ Basement w/plumbing

Garbage Disposal: ☐ Yes ☑ No

Auto. Dishwasher: ☑ Yes ☐ No


Auto. Washing Machine: ☑ Yes ☐ No

Other ____

☐ Basement wo/plumbing

Comments TRENCH DEPTH 32" MAXIMUM
DROP BOX PER DRAIN LINE

INITIAL SITE SKETCH

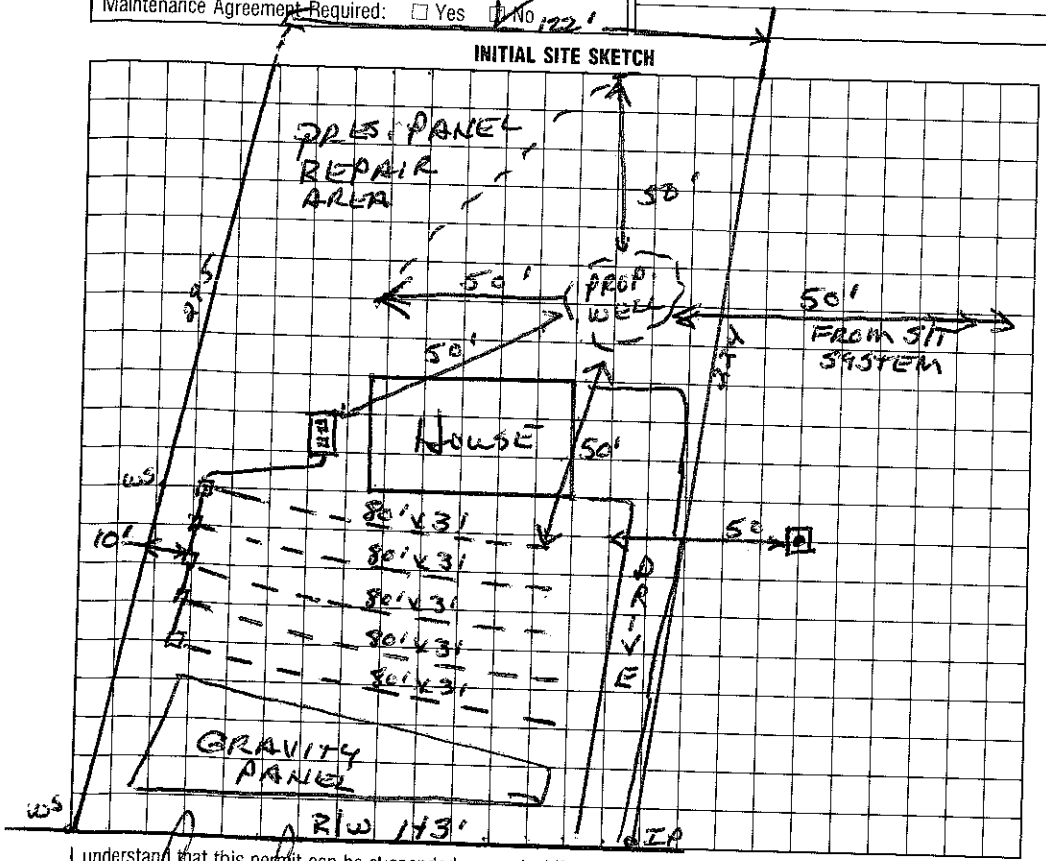

AS BUILT SKETCH

As shown on IP except tank parallel to house.

I understand that this permit can be suspended or revoked if any false information is supplied toward securing the permit/any unauthorized changes are made to the site/any unauthorized changes are made in the installation of the system. Improvement Permit is valid for 60 months from date of issuance.

Signed: Paul Dinsmore

Improvement Permit by: Wesley Sparks R.S. date 7/28/93

Existing System Inspection by: ____ date ____

Installed by: Curt Dunning Const.

Certificate of Completion by: D. Hoffman, R.S. date 8/5/93

Operation Permit by: ____ date ____

HEALTH DEPT. COPY: WHITE INSPECTION COPY (FINAL): GREEN OWNER COPY (FINAL): YELLOW INSPECTION COPY (INITIAL): PINK OWNER COPY (INITIAL): GOLD