IREDELL COUNTY HEALTH DEPARTMENT

STATESVILLE 704-878-5305 MOORESVILLE 704-664-5281

IMPROVEMENT PERMIT / ~~CERTIFICATE OF COMPLETION~~ / OPERATION PERMIT / EXISTING SYSTEM INSPECTION

AUTHORIZATION TO CONSTRUCT 11:00

PROPERTY DESCRIPTION NO. 5070 - MOORESVILLE DATE 10/9/97 TAX MAP NO. 4657696597

OWNER OR CONTRACTOR CHRIS KAMIONKA PHONE: Business _____ Home 717-675-5920 Watershed: ☐ Yes ☑ No

ADDRESS RR 4 BOX 395K DALLAS PA 18612

LOCATION 150 - TL RITNER RD - TL PITCHER DR - ON RT

SUBDIVISION KETCHIE ACRES BLOCK / SECTION 1 LOT 17 LOT AREA 1AC SITE CLASS. PS DESIGN FLOW 360 L.T.A.R. 3

Septic Tank: 1000 Gallons; STB 825 Date 1-11-98

Pump Tank: _____ Gallons; PT _____ Date _____

Pump Make: _____ Model _____ Serial No. _____

Nitrification Field: No Fields 1 Square Feet 900 Linear Feet 300

No Lines 4 @ 75 Trench Width 36" Max Trench Bottom Depth 36" Gravel Depth N/A

☑ New System ☐ Repair System Type: I, II, III, IV, V, VI

System Description: GRAVITY CHAMBERED ORDS

Repair System Description: SAME

Maintenance Agreement Required: ☐ Yes ☑ No

☑ House/Mod. Home No. Bedrooms 3

☐ Mobile Home No. Bathrooms 3

☐ Business No. Employees _____

☐ Other _____


☐ Slab ☑ Crawl Space ☐ Basement w/plumbing ☐ Basement wo/plumbing

Water Supply: ☑ Individual ☐ Community ☐ Public


Comments:

Comments:

INITIAL SITE SKETCH 1" = 50'

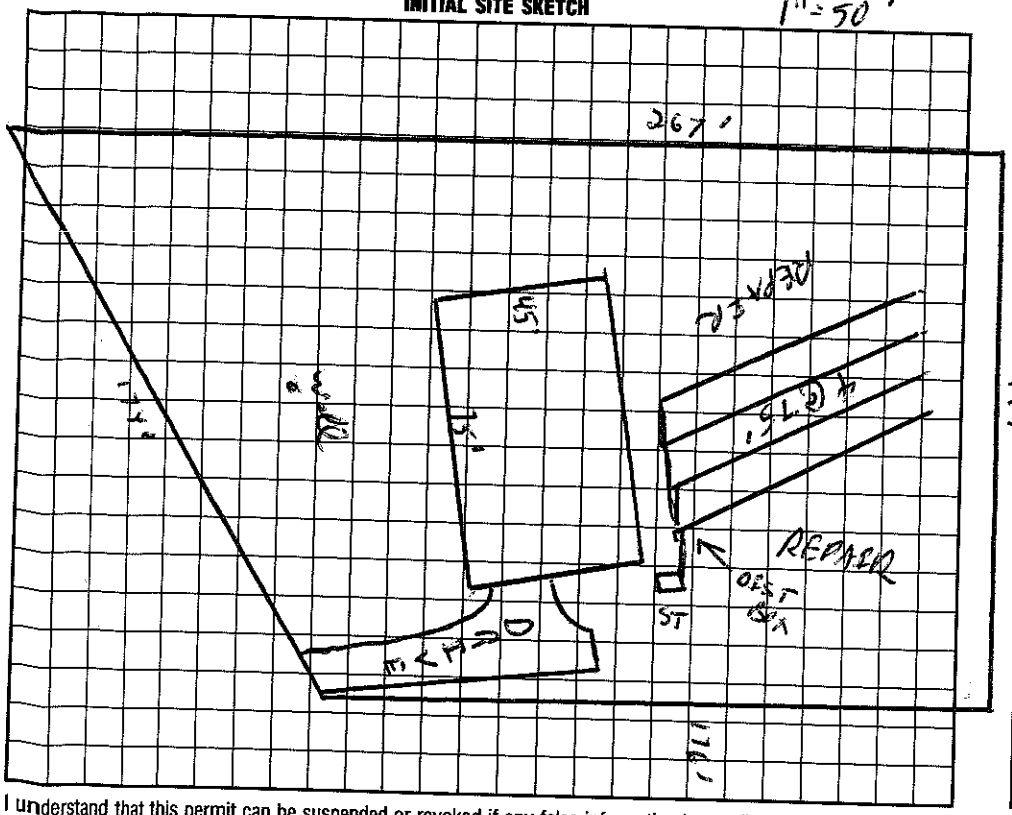

AS BUILT SKETCH

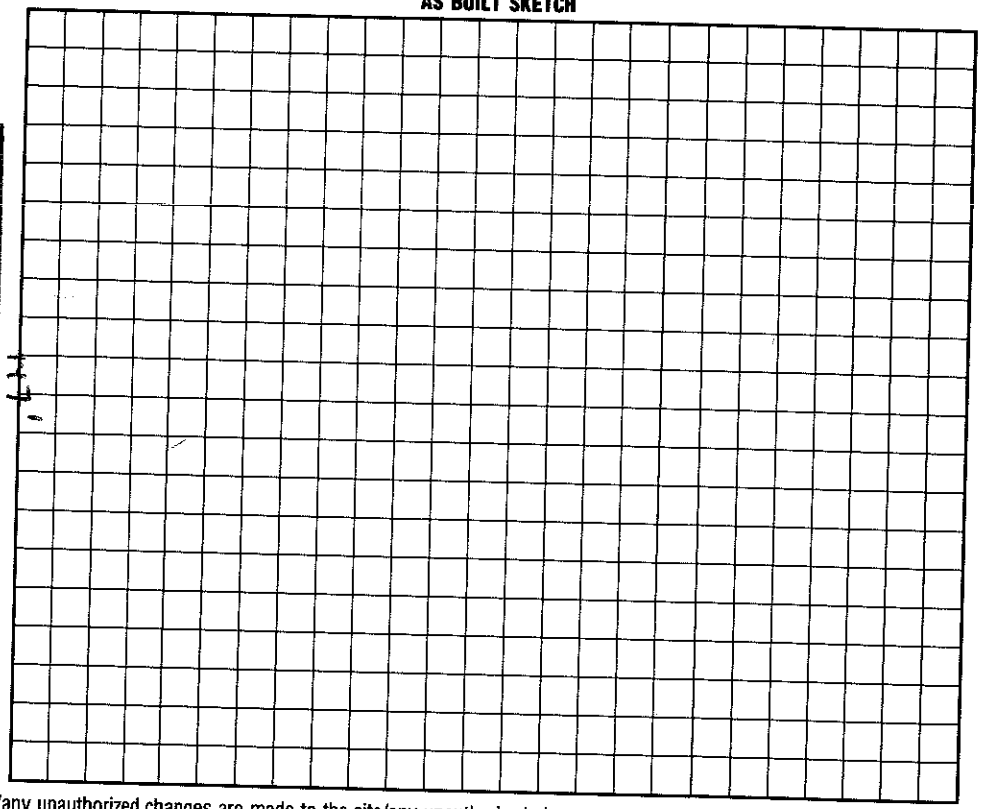

I understand that this permit can be suspended or revoked if any false information is supplied toward securing the permit/any unauthorized changes are made to the site/any unauthorized changes are made in the installation of the system. Improvement Permit is valid for 60 months from date of issuance.

Signed: _____

Improvement Permit by: C. R. Jean RS date 10/9/97

AUTHORIZATION TO CONSTRUCT

~~Existing System Inspection by~~: C. R. Jean RS date 10/9/97

Installed by: CHRIS KAMIONKA

Certificate of Completion by: _____ date _____

Operation Permit by: C. R. Jean RS date 3/30/98

HEALTH DEPT. COPY: WHITE INSPECTION COPY (FINAL): GREEN OWNER COPY (FINAL): YELLOW INSPECTION COPY (INITIAL): PINK OWNER COPY (INITIAL): GOLD