IREDELL COUNTY HEALTH DEPARTMENT

→ AUTHORIZATION TO CONSTRUCT

STATESVILLE 704-878-5305 MOORESVILLE 704-664-5281

IMPROVEMENT PERMIT / ~~CERTIFICATE OF COMPLETION~~ / OPERATION PERMIT / EXISTING SYSTEM INSPECTION

PROPERTY DESCRIPTION NO. 5018 - MOORESVILLE DATE 8/27/97 TAX MAP NO. 1M16A29 Watershed: ☐ Yes ☑ No

OWNER OR CONTRACTOR JASON BURLE PHONE: Business 4657-69-7299 Home 596-9962

ADDRESS PO BOX 1341 DAVIDSON NC 28036

LOCATION RINEHARDT RD - TL KETCHIE DR - ON LEFT

SUBDIVISION KETCHIE ACRES BLOCK / SECTION I LOT 29 LOT AREA .9556 SITE CLASS. NS DESIGN FLOW 360 L.T.A.R. .35

Septic Tank: 1000 Gallons; STB 825 Date 4/9/99

Pump Tank: _____ Gallons; PT _____ Date _____

Pump Make: _____ Model _____ Serial No. _____

Nitrification Field: No Fields 1 Square Feet 1032 Linear Feet 344

No Lines 4@86' Trench Width 36" Max Trench Bottom Depth 36" Gravel Depth 12"

☑ New System ☐ Repair System Type: I, (II), III, IV, V, VI

System Description: GRAVITY CONVENTIONAL

Repair System Description: SAME

Maintenance Agreement Required: ☐ Yes ☑ No

☑ House/Mod. Home No. Bedrooms 3

☐ Mobile Home No. Bathrooms 2

☐ Business No. Employees ____

☐ Other _____


☐ Slab ☑ Crawl Space ☐ Basement w/plumbing ☐ Basement wo/plumbing

Water Supply:
☑ Individual
☐ Community
☐ Public


Comments:

Comments:

INITIAL SITE SKETCH 1" = 50'

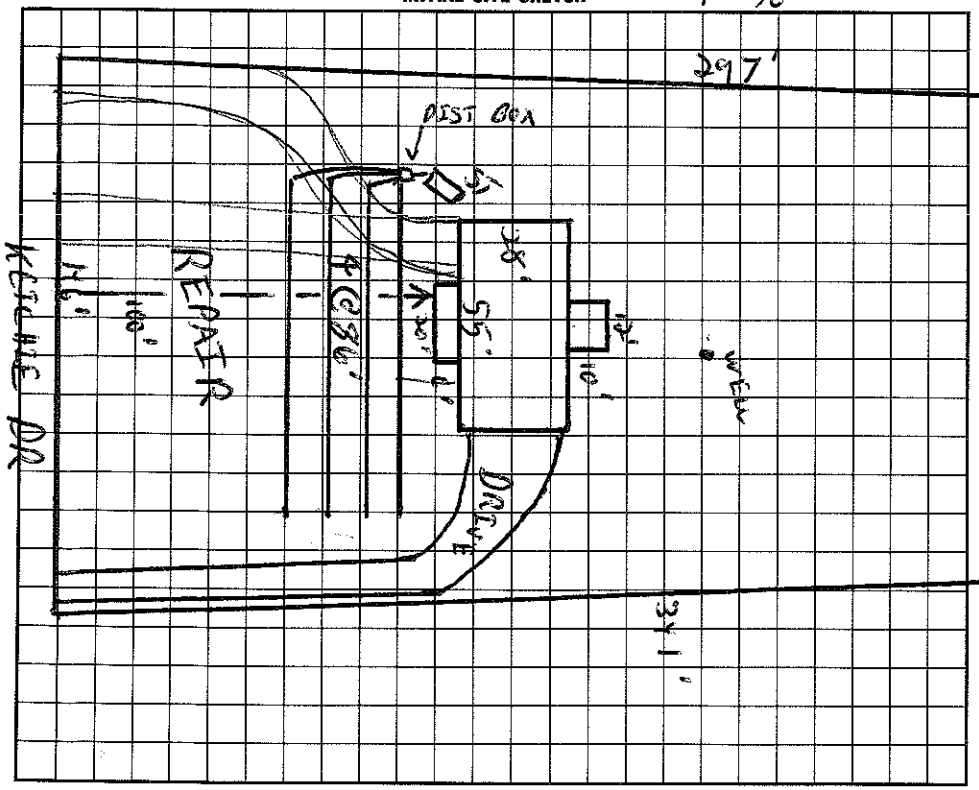

AS BUILT SKETCH

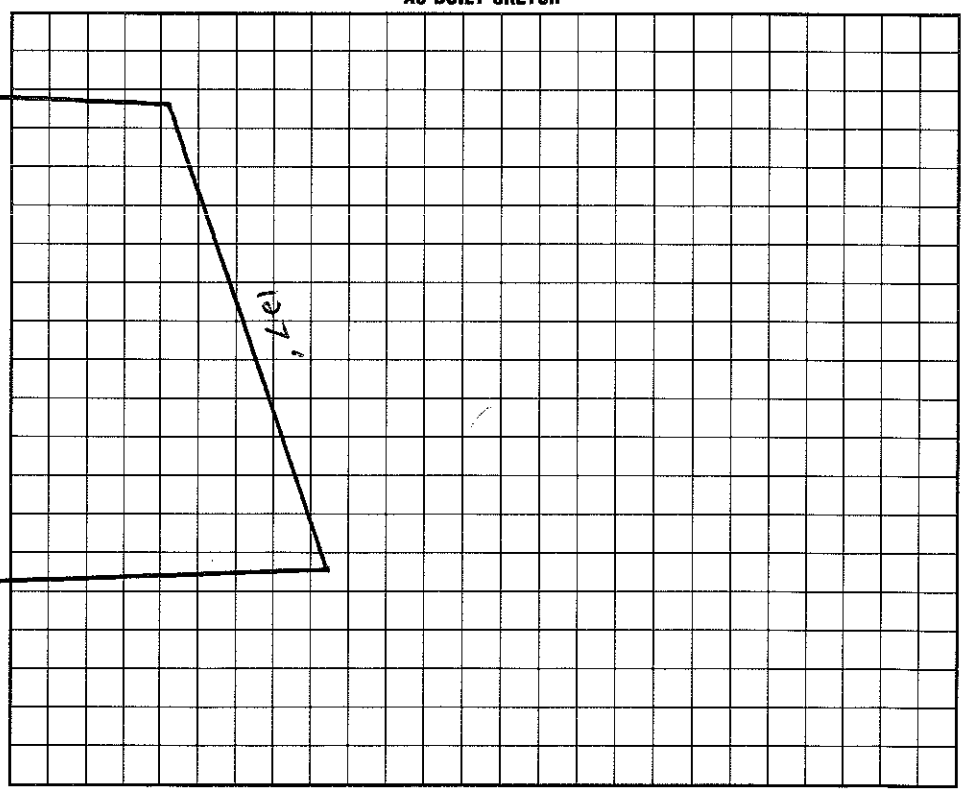

I understand that this permit can be suspended or revoked if any false information is supplied toward securing the permit/any unauthorized changes are made to the site/any unauthorized changes are made in the installation of the system. Improvement Permit is valid for 60 months from date of issuance.

Signed: _____

Improvement Permit by: C. Thomas date 8/28/97

~~Existing System Inspection by:~~ AUTHORIZATION TO CONSTRUCT C. Thomas date 2/28/97

Installed by: D. Bostain

Certificate of Completion by: _____ date _____

Operation Permit by: _____ date 5/12/99

HEALTH DEPT. COPY: WHITE INSPECTION COPY (FINAL): GREEN OWNER COPY (FINAL): YELLOW INSPECTION COPY (INITIAL): PINK OWNER COPY (INITIAL): GOLD