IREDELL COUNTY HEALTH DEPARTMENT

STATESVILLE 704-878-5305 MOORESVILLE 704-664-5281

IMPROVEMENT PERMIT / AUTHORIZATION TO CONSTRUCT / OPERATION PERMIT / EXISTING SYSTEM INSPECTION

PERMIT# 13812 PIN# 4657697726 DATE 11-30-05

OWNER OR APPLICANT Gloria Morrison & (owner Mary Ketchie) PHONE: Business 704-663-3655 Home

ADDRESS 522 River Hwy 28117 Debra Yager

LOCATION 150 E TL Rinehardt TL Sun Lane on left

SUBDIVISION Ketchie Acres BLOCK / SECTION 2 LOT 15 LOT AREA .6 Ac SITE CLASS. PS DESIGN FLOW 360 gpd L.T.A.R. .3 gpd/ft²

Septic Tank: 1000 Gallons; STB 744 Date 3-8-06
Pump Tank: Gallons; PT Date
Pump Make: Model Serial No.
Nitrification Field: No Fields 1 Square Feet 1200 Linear Feet 200
No Lines 4@50' Trench Width 24" Max Trench Bottom Depth 36" Gravel Depth NA

☒ New System ☐ Repair ☐ Expansion System Type: I II (III) IV V VI
System Description: Panel Block, Gravity
Repair System Description: Panel Block
Maintenance Agreement Required: ☐ Yes ☒ No

☒ House/Mod. Home No. Bedrooms 3
☐ Mobile Home No. Persons
☐ Business No. Employees
☐ Other


Water Supply: ☒ Individual ☐ Public ☐ Community

☒ Gravity ☐ Pressure ☐ Slab ☒ Crawl Space ☐ Basement w/plumbing ☐ Basement wo/plumbing


Comments:/Conditions: 47 panels. Remove 20" fill material before A.C. Use effluent flow splitter such as Zoehler Install subsurface intercept drainage ditch 18" wide, 48" deep w/ 1% Fall minumum out to daylight - fill w/stone

Comments:/Conditions: 5/26/06 Renewed for plans. house slightly larger but should still fit.

INITIAL SITE SKETCH 1"=50'

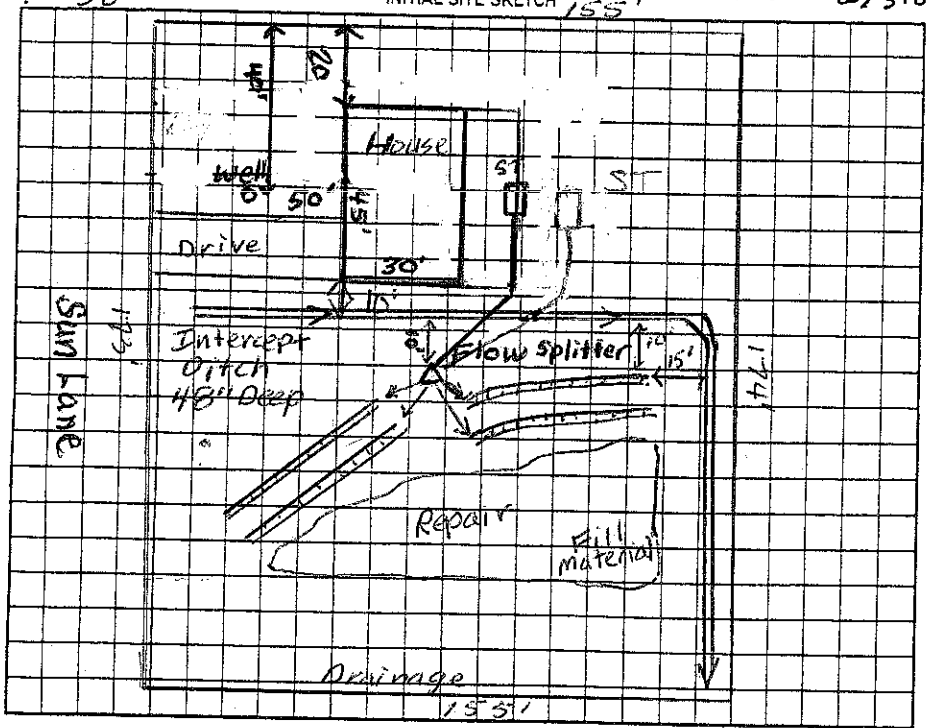

AS-BUILT SKETCH

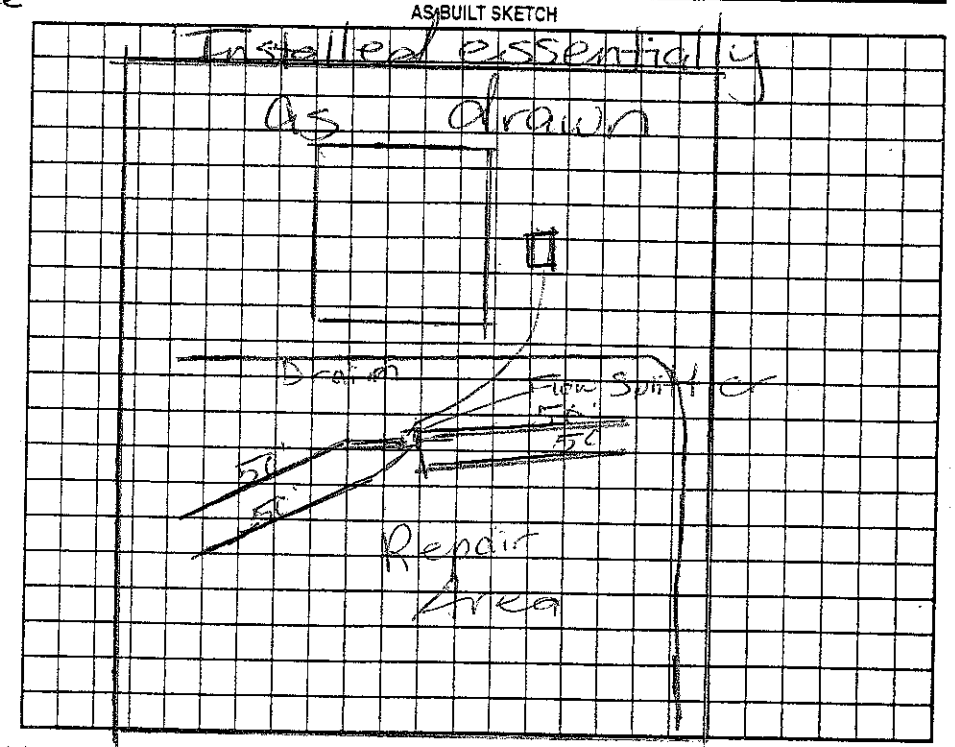

Permit can be suspended or revoked if any false information is supplied toward securing the permit/any unauthorized changes are made to the site/any unauthorized changes are made in the installation of the system. Improvement Permit with plat valid without expiration ☐ Improvement Permit with site plan valid for sixty months ☐ Authorization to Construct is valid for a period equal to that of Improvement Permit – not to exceed sixty months.

Signed: Gloria Morrison, LNR date 12-6-05 Installed by: Larry Beam RS

Improvement Permit by: Judy Melilla date 12-1-05 Operation Permit by: Marian H. Wilson date 10/10/06

Authorization to Construct by: Marian H. Wilson date 5/26/05 Existing System Inspection by: date

HEALTH DEPT. COPY: WHITE OWNER COPY (FINAL): YELLOW OWNER COPY (INITIAL): PINK