4657-69-8549

IREDELL COUNTY HEALTH DEPARTMENT

STATESVILLE 704-878-5305 MOORESVILLE 704-664-5281

IMPROVEMENT PERMIT / CERTIFICATE OF COMPLETION / OPERATION PERMIT / EXISTING SYSTEM INSPECTION

PROPERTY DESCRIPTION NO. 2234 DATE 8/20/93 TAX MAP NO. 1M 16A 18

OWNER OR CONTRACTOR P.K. HILLARD PHONE: Business Home 663-0633

ADDRESS RINEHART RD. (L) FIRST KETCHIE RD. ON (R) JUST BEFORE SUNSHINE ESTATES

LOCATION

SUBDIVISION KETCHIE ACRES BLOCK / SECTION LOT 18 LOT AREA .61 SITE CLASS. P L.T.A.R. .3

Water Supply: ☑ Individual ☐ Community ☐ Public

Septic Tank: 1000 Gallons; STB Date

Pump Tank: Gallons; PT Date

Nitrification Field: No Fields 1 Square Feet 1200 Linear Feet 399

No Lines 3 Trench Width 36" Trench Depth 36" Gravel Depth 12"

☑ New System ☐ Repair System Type: I (II) III, IV, V, VI

System Description: CONV - DIST BOX

Repair System Description: SAME

Maintenance Agreement Required: ☐ Yes ☑ No

☑ House/Mod. Home No. Bedrooms 3

☐ Mobile Home No. Bathrooms 2

☐ Business No. Employees

☐ Other

☐ Slab ☑ Crawl Space ☐ Basement w/plumbing ☐ Basement wo/plumbing

Garbage Disposal: ☐ Yes ☑ No


Auto. Dishwasher: ☑ Yes ☐ No

Auto. Washing Machine: ☑ Yes ☐ No

Other

Comments

144' INITIAL SITE SKETCH

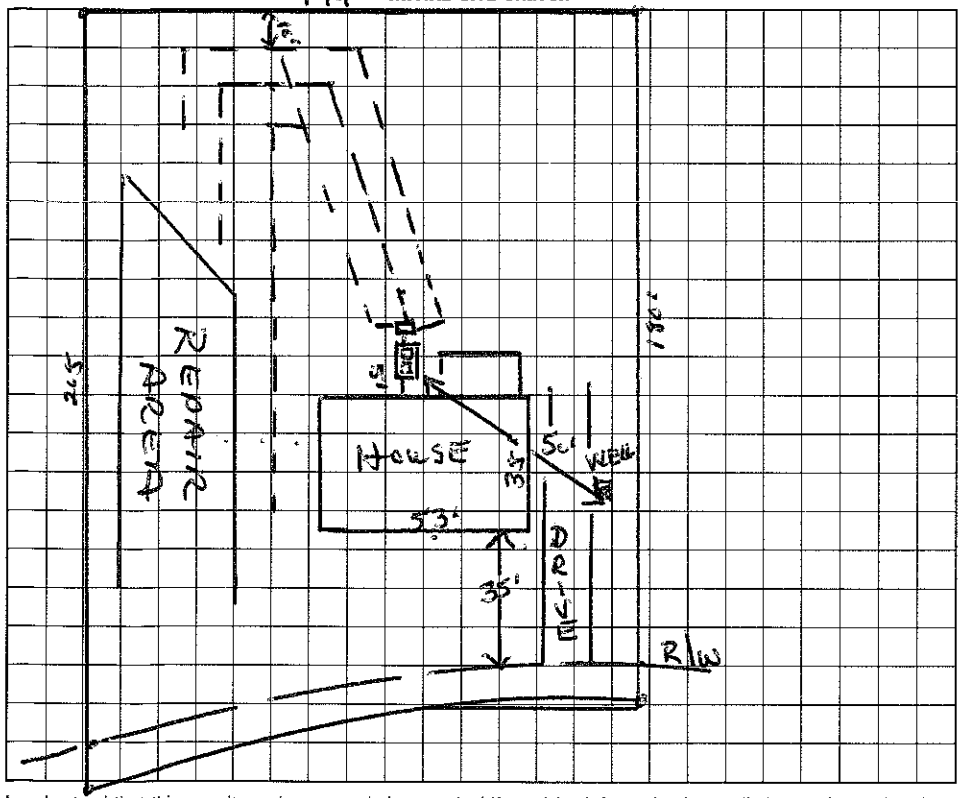

AS BUILT SKETCH

I understand that this permit can be suspended or revoked if any false information is supplied toward securing the permit/any unauthorized changes are made to the site/any unauthorized changes are made in the installation of the system. Improvement Permit is valid for 60 months from date of issuance.

Signed:

Improvement Permit by: Wesley Sparks RS. date 8/20/93

Existing System Inspection by: date

Installed by:

Certificate of Completion by: date

Operation Permit by: date

HEALTH DEPT. COPY: WHITE INSPECTION COPY (FINAL): GREEN OWNER COPY (FINAL): YELLOW INSPECTION COPY (INITIAL): PINK OWNER COPY (INITIAL): GOLD

IREDELL COUNTY HEALTH DEPARTMENT

STATESVILLE 704-878-5305 MOORESVILLE 704-664-5281

IMPROVEMENT PERMIT / CERTIFICATE OF COMPLETION / OPERATION PERMIT / EXISTING SYSTEM INSPECTION

PROPERTY DESCRIPTION NO. 2234 DATE 10/5/93 TAX MAP NO. IM 16 A 18

OWNER OR CONTRACTOR PK HILLARD. PHONE: Business Home 663-0633

ADDRESS

LOCATION RHINEHART RD. TL INTO 1ST KETCHIE DR, NEXT LAST LOT ON R BEFORE SUNSHINE ESTATES

SUBDIVISION KETCHIE ACRES BLOCK / SECTION LOT 18 LOT AREA ~ 20,000 FT² SITE CLASS. P L.T.A.R. .25 - .3

Water Supply: ☐ Individual ☐ Community ☐ Public

Septic Tank: 1000 Gallons; STB 825 Date 8/15/93

Pump Tank: Gallons; PT Date

Nitrification Field: No Fields 1 Square Feet 1260 Linear Feet 420

No Lines 3 Trench Width 3' Trench Depth Gravel Depth

☑ New System ☐ Repair System Type: I (II) II, IV, V, VI

System Description: CONV - DIST BOX

Repair System Description: PANEL

Maintenance Agreement Required: ☐ Yes ☐ No

☑ House/Mod. Home No. Bedrooms 3 Garbage Disposal: ☐ Yes ☑ No

☐ Mobile Home No. Bathrooms 2 Auto. Dishwasher: ☑ Yes ☐ No

☐ Business No. Employees Auto. Washing Machine: ☑ Yes ☐ No


☐ Other Other

☐ Slab ☑ Crawl Space ☐ Basement w/plumbing ☐ Basement wo/plumbing

Comments DIVERSION DITCH TO BE INSTALLED AS SHOWN

INITIAL SITE SKETCH

AS BUILT SKETCH

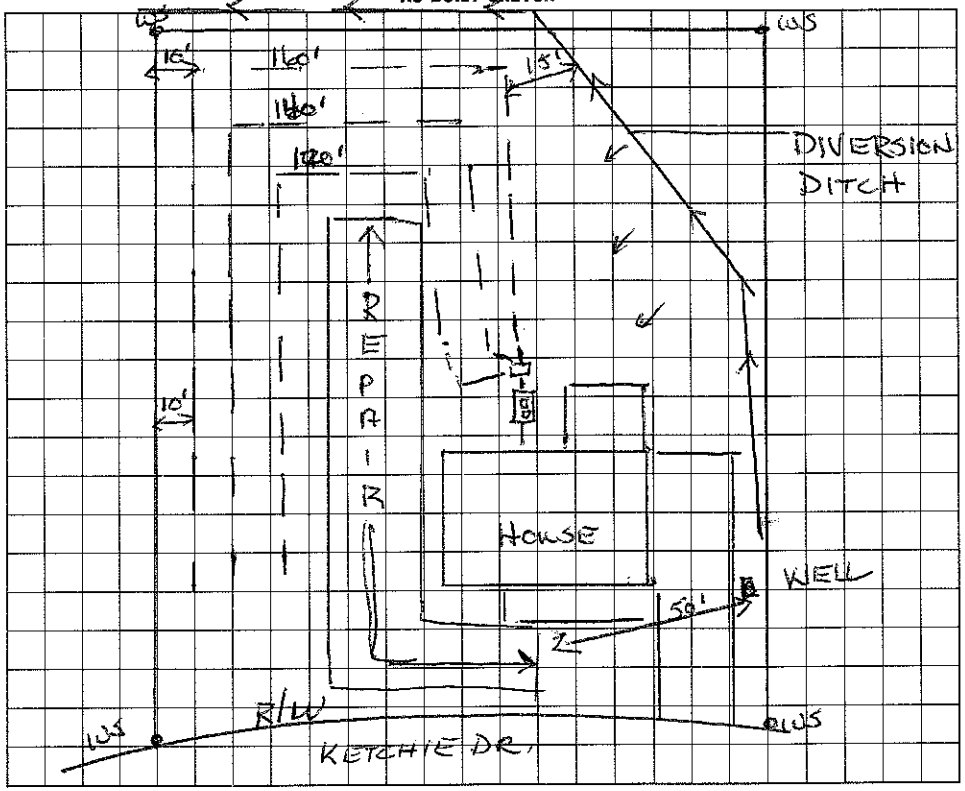

I understand that this permit can be suspended or revoked if any false information is supplied toward securing the permit/any unauthorized changes are made to the site/any unauthorized changes are made in the installation of the system. Improvement Permit is valid for 60 months from date of issuance.

Signed:

Improvement Permit by: date

Existing System Inspection by: date

Installed by: Rowan Septic Tank

Certificate of Completion by: Wesley Sparks RS. date 10/5/93

Operation Permit by: date

HEALTH DEPT. COPY: WHITE INSPECTION COPY (FINAL): GREEN OWNER COPY (FINAL): YELLOW INSPECTION COPY (INITIAL): PINK OWNER COPY (INITIAL): GOLD