IREDELL COUNTY HEALTH DEPARTMENT

STATESVILLE 704-878-5305 (2:30) MOORESVILLE 704-664-5281

IMPROVEMENT PERMIT / AUTHORIZATION TO CONSTRUCT / OPERATION PERMIT / EXISTING SYSTEM INSPECTION

PERMIT# 5012 PIN# 4657699320 DATE 2/4/98

OWNER OR CONTRACTOR William Harris PHONE: Business _____ Home 664-1646

ADDRESS PO Box 1210 Mooresville NC 28115

LOCATION Hwy 150 to Rinehart Rd. TL to Ketchie Rd TL 5th lot on left

SUBDIVISION Ketchie Acres BLOCK / SECTION 1 LOT 28 LOT AREA 1.0 Acre SITE CLASS. PS. DESIGN FLOW 300gpd L.T.A.R. .3

Septic Tank: 1000 Gallons; STB 183 Date 12/1/97

Pump Tank: _____ Gallons; PT _____ Date _____

Pump Make: _____ Model _____ Serial No. _____

Nitrification Field: No Fields 1 Square Feet 1200' Linear Feet 400'

No Lines 3 at 100' Trench Width 36" Max Trench Bottom Depth 36" Gravel Depth N/A

☒ New System ☐ Repair System Type: I, II, III, IV, V, VI

System Description: Grav. - Plastic Chambers S.M.

Repair System Description: Pump - Conv/P.I.Cham.

Maintenance Agreement Required: ☐ Yes ☐ No

☒ House/Mod. Home ☐ Mobile Home ☐ Business ☐ Other

No. Bedrooms 3 No. Bathrooms 2 No. Employees _____

☐ Slab ☒ Crawl Space ☐ Basement w/plumbing ☐ Basement wo/plumbing


Water Supply: ☒ Individual ☐ Public ☐ Community

Comments:/Conditions: Feather off old Farm Berms. Keep Septic System 10' from Property lines, at least 50' from any well and 5' from house.


Comments:/Conditions: Plumbing must be stubbed out to maintain fall btw Septic tank & Drain field.

INITIAL SITE SKETCH

Scale 1:60

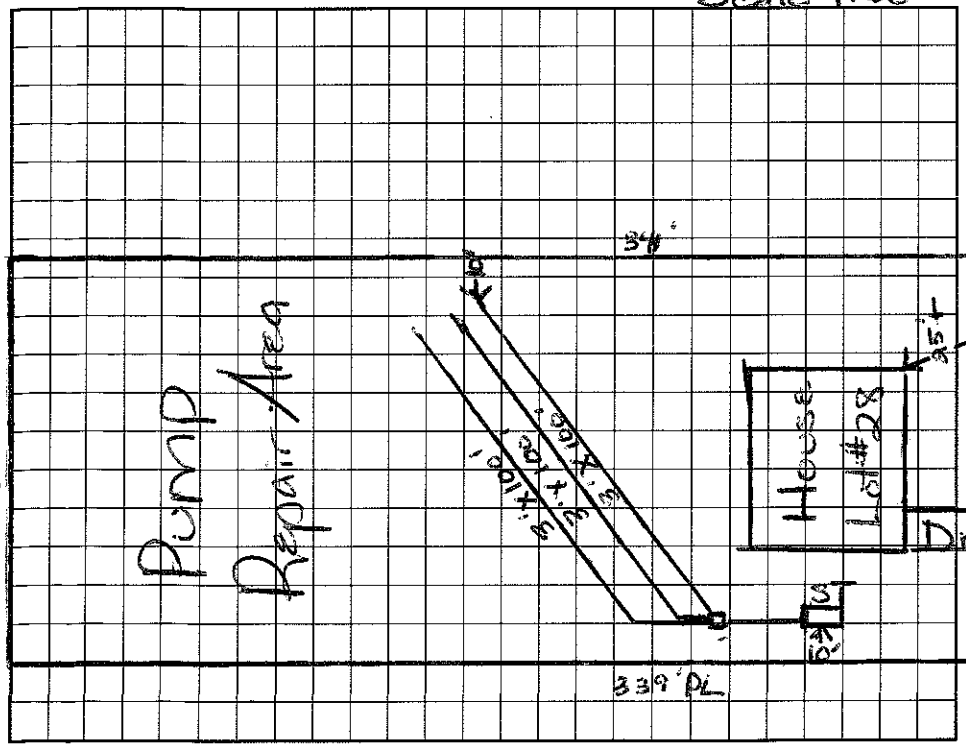

AS BUILT SKETCH

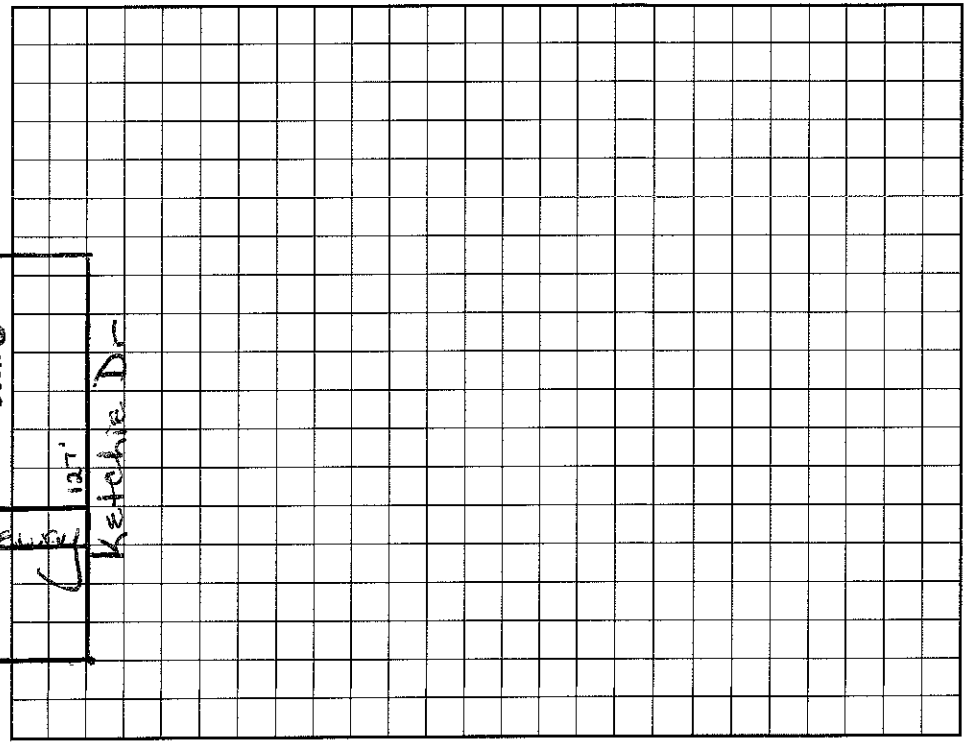

I understand that this permit can be suspended or revoked if any false information is supplied toward securing the permit/any unauthorized changes are made to the site/any unauthorized changes are made in the installation of the system. Improvement Permit with plat valid without expiration. Improvement Permit with site plan valid for sixty months. Authorization to Construct is valid for a period equal to that of Improvement Permit – not to exceed sixty months.

Signed: William E. Harris date _____ Installed by: DAVID MILLER

Improvement Permit by: Marvin H. Dotson date 2/4/98 Operation Permit by: _____ date _____

Authorization to Construct by: Marvin H. Dotson date 2/4/98 Existing System Inspection by: [illegible] Freeman date 2/9/98

HEALTH DEPT. COPY: WHITE INSPECTION COPY (FINAL): GREEN OWNER COPY (FINAL): YELLOW INSPECTION COPY (INITIAL): PINK OWNER COPY (INITIAL): GOLD