IREDELL COUNTY HEALTH DEPARTMENT

STATESVILLE 704-878-5305 MOORESVILLE 704-664-5281

IMPROVEMENT PERMIT / CERTIFICATE OF COMPLETION / OPERATION PERMIT / EXISTING SYSTEM INSPECTION

PROPERTY DESCRIPTION NO. 2265 DATE 6/10/93 TAX MAP NO. 1M16A11

OWNER OR CONTRACTOR PETE BELK CONST. ~~PHONE: Business~~ 4657-72-4764 Home 663-1638

ADDRESS SUN LANE MOORESVILLE, NC.

LOCATION RINEHART RD, TL ON SUN LANE 2ND Lot ON (L)

SUBDIVISION KETCHIEACRE BLOCK / SECTION II LOT 11 LOT AREA ~20,000 FT² SITE CLASS. P L.T.A.R. .3

Water Supply: ☐ Individual ☐ Community ☐ Public

Septic Tank: 1000 Gallons; STB 358 Date

Pump Tank: Gallons; PT Date

Nitrification Field: No Fields 1 Square Feet 1200 Linear Feet 400

No Lines 4 Trench Width 3' Trench Depth 36" Gravel Depth 12"

☑ New System ☐ Repair System Type: I, II (III) IV, V, VI

System Description: CONV.

Repair System Description: CONV.

Maintenance Agreement Required: ☐ Yes ☑ No

☑ House/Mod. Home ☐ Mobile Home ☐ Business ☐ Other

No. Bedrooms 3 No. Bathrooms 2 No. Employees

Garbage Disposal: ☐ Yes ☑ No

Auto. Dishwasher: ☑ Yes ☐ No

Auto. Washing Machine: ☑ Yes ☐ No


Other

☑ Slab ☐ Crawl Space ☐ Basement w/plumbing ☐ Basement wo/plumbing

Comments

INITIAL SITE SKETCH

AS BUILT SKETCH

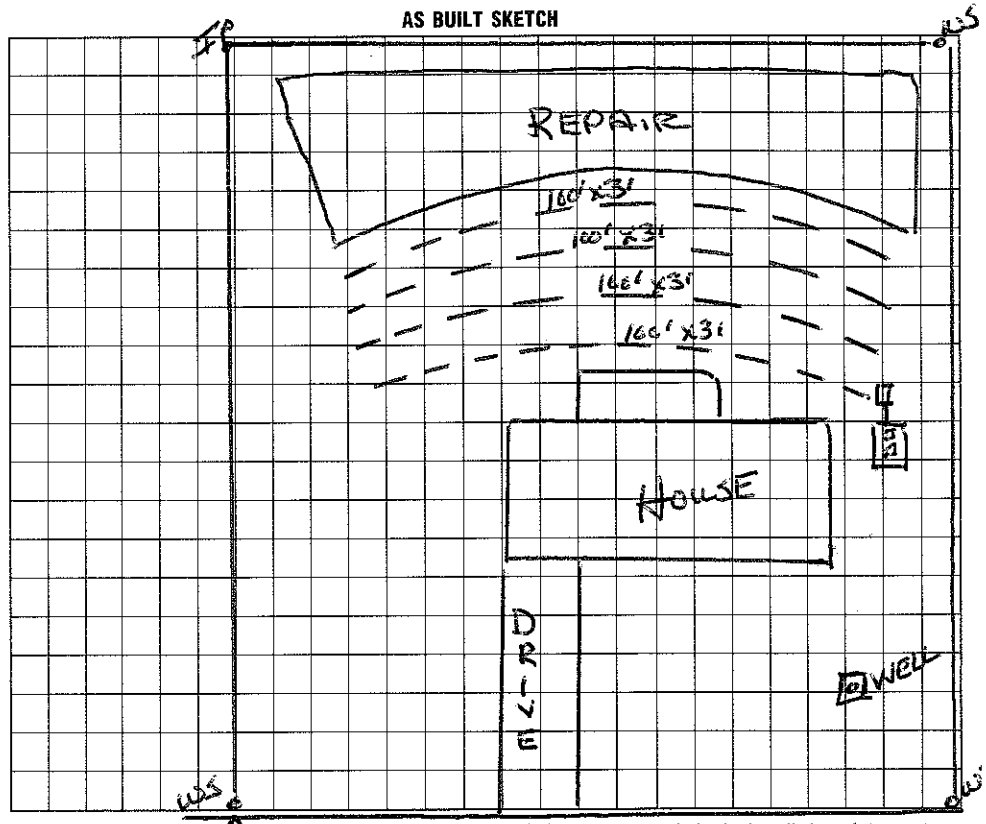

I understand that this permit can be suspended or revoked if any false information is supplied toward securing the permit/any unauthorized changes are made to the site/any unauthorized changes are made in the installation of the system. Improvement Permit is valid for 60 months from date of issuance.

Signed:

Improvement Permit by: date

Existing System Inspection by: date

Installed by: RAY BEAM

Certificate of Completion by: Wesley Sparks RS. date 6/10/93

Operation Permit by: date

HEALTH DEPT. COPY: WHITE INSPECTION COPY (FINAL): GREEN OWNER COPY (FINAL): YELLOW INSPECTION COPY (INITIAL): PINK OWNER COPY (INITIAL): GOLD