9:30

IREDELL COUNTY HEALTH DEPARTMENT

STATESVILLE 704-878-5305 MOORESVILLE 704-664-5281

IMPROVEMENT PERMIT / AUTHORIZATION TO CONSTRUCT / OPERATION PERMIT / EXISTING SYSTEM INSPECTION

PERMIT # 157507 PIN # 4657-79-5567 DATE 7-23-09

OWNER or APPLICANT DAVID MEEHAN PHONE: Business 704-528-6378 Home:

OWNER or APPLICANT ADDRESS 105 GALAX DR SVILLE 28677

LOCATION / DIRECTIONS HWY 150, TR RINEHARDT RD, CORNER OF KETCHIE & RINEHARDT

SUBDIVISION KETCHIE ACRES BLOCK / SECTION LOT # 23 LOT AREA .534AC DESIGN FLOW 360 L.T.A.R. .25

Septic Tank 1000 Gallons: STB 794 Date 10-18-09

Pump Tank Gallons: P T Date

Pump Make Model Serial #

Nitrification Field No Fields 1 No Lines 5 Linear Feet 250'

Trench Width 24-36" Max. Trench Bottom Depth 36" Gravel Depth SAND

☒ New System ☐ Repair ☐ Expansion System Type I II (III) IV V VI

System Description: GRAVITY PANEL BLOCK

Repair System Description: LP- PANEL BLOCK

Maintenance Agreement Required ☐ YES ☒ NO INITIALLY

☐ GRAVITY ☐ PRESSURE

☒ Residence ☐ Business ☐ Other ☐ Slab ☒ Crawl Space ☐ Basement w/plumbing ☐ Basement w/o plumbing


No. Bedrooms 3 No. Persons No. Employees

Water Supply: ☒ Private ☐ Public ☐ Community


Comments / Conditions

Comments / Conditions 1) LOT MUST BE GRADED TO SHED WATER TOP WILL NOT BE ISSUED UNTIL THIS IS DONE 2) KEEP DRAIN LINES MIN 50' FROM ANY WELL 3) DO NOT DISTURB SEPTIC AREA WHILE GRADING

INITIAL SITE SKETCH

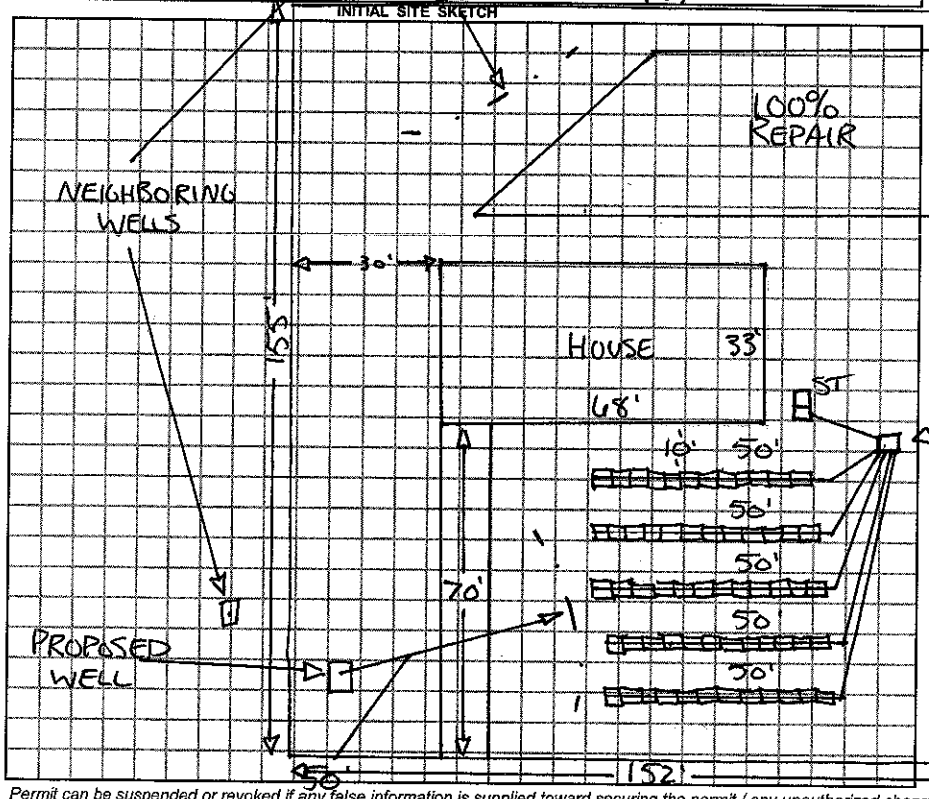

AS BUILT SKETCH

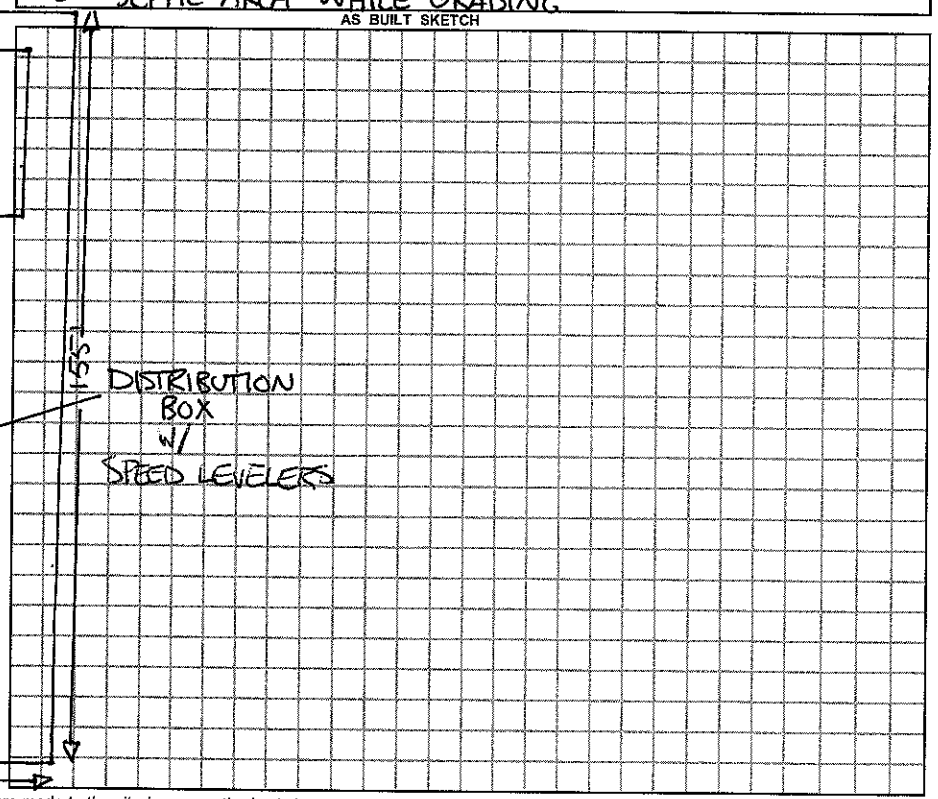

Permit can be suspended or revoked if any false information is supplied toward securing the permit / any unauthorized changes are made to the site / any unauthorized changes are made in the installation of the system.

☐ IMPROVEMENT PERMIT w / plat valid without expiration. ☒ IMPROVEMENT PERMIT w / site plan valid for 60 mos. ☒ AUTHORIZATION TO CONSTRUCT valid for period equal to IMPROVEMENT PERMIT-not to exceed 60 mo.

Owner / Applicant Signature: David Meehan Date 7/28/09

Improvement Permit by: R-A-Coff Date 7-23-09

Authorzation to Construct by: JR-A-Coff Date 7-23-09

YOU SHOULD CONTACT A LOCATOR SERVICE PRIOR TO ANY EXCAVATION.

Installed by: LARRY BEAM

Operation Permit by: R-A-Coff REHS Date: 3-18-10

Existing System Inspected by: Date:

WHITE COPY Environmental Health YELLOW COPY (Final) Owner / Applicant PINK COPY (Initial) Owner / Applicant