IREDELL COUNTY HEALTH DEPARTMENT

4657799946

STATESVILLE 704-878-5305 MOORESVILLE 704-664-5281

IMPROVEMENT PERMIT / CERTIFICATE OF COMPLETION / OPERATION PERMIT / EXISTING SYSTEM INSPECTION

PROPERTY DESCRIPTION NO. 2580 DATE 2/10/94 TAX MAP NO. 1M A 96A Watershed: ☐ Yes ☒ No

OWNER OR CONTRACTOR MIKE SHUFELT PHONE: Business Home 664-2584

ADDRESS Rt 8 Box 161 Mooresville NC.

LOCATION RHINEHARDT RD. FROM 115 AROUND CURVE TO 5TH HOUSE ON L

SUBDIVISION N/A BLOCK / SECTION LOT LOT AREA SITE CLASS. P DESIGN FLOW 480 L.T.A.R. .35

Septic Tank: 1000 Gallons; STB EXISTING Date 6

Pump Tank: Gallons; PT Date

Pump Make: Model Serial No.

Nitrification Field: No Fields Square Feet 1260 Linear Feet 420

No Lines 8 6 Trench Width 3 Max Trench Bottom Depth 36" Gravel Depth 12"

☐ New System ☒ Repair System Type: I, II, III, IV, V, VI

System Description: CONV - DROP BOXES

Repair System Description: CONV.

Maintenance Agreement Required: ☐ Yes ☒ No

☐ House/Mod. Home No. Bedrooms 4

☐ Mobile Home No. Bathrooms 2

☐ Business No. Employees

☐ Other


☐ Slab ☐ Crawl Space ☐ Basement w/plumbing ☐ Basement wo/plumbing

Water Supply: ☒ Individual ☐ Community ☐ Public


Comments: MINIMUM REPAIR REMAINS - TRENCHES COULD BE REDUCED BY 50% WITH USE OF PREFAB. PANEL BLOCKS TRENCH DEPTH 36" MAXIMUM

Comments:

INITIAL SITE SKETCH

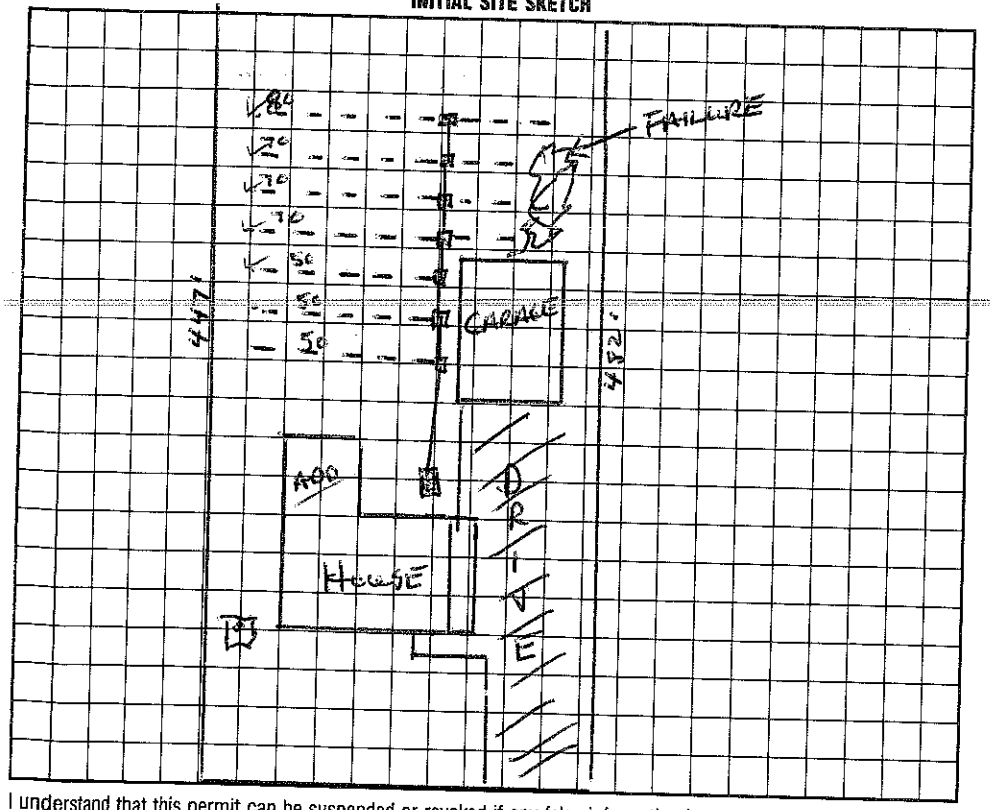

AS BUILT SKETCH

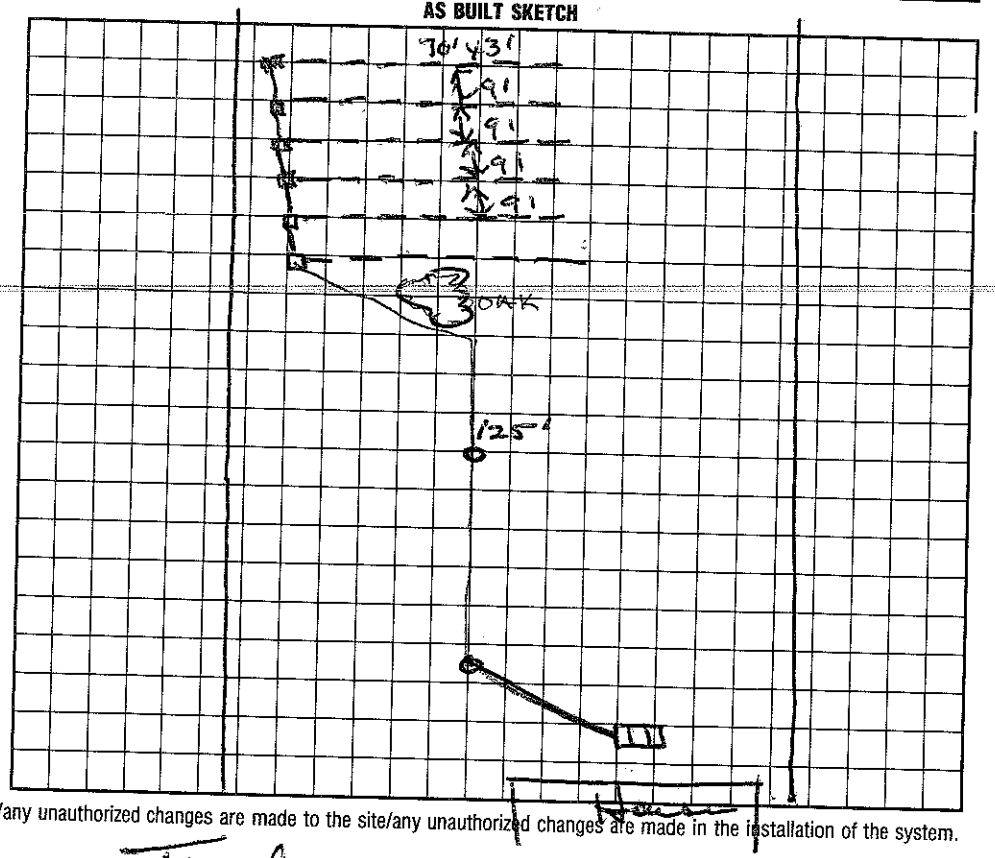

I understand that this permit can be suspended or revoked if any false information is supplied toward securing the permit/any unauthorized changes are made to the site/any unauthorized changes are made in the installation of the system. Improvement Permit is valid for 60 months from date of issuance.

Signed:

Improvement Permit by: Wesley Sparks RS. date 2/10/94

Existing System Inspection by: date

Installed by: Tim Simmons

Certificate of Completion by: Wesley Sparks RS. date 4/11/94

Operation Permit by: date

HEALTH DEPT. COPY: WHITE INSPECTION COPY (FINAL): GREEN OWNER COPY (FINAL): YELLOW INSPECTION COPY (INITIAL): PINK OWNER COPY (INITIAL): GOLD