12:00

IREDELL COUNTY HEALTH DEPARTMENT

STATESVILLE 704-878-5305 MOORESVILLE 704-664-5281

IMPROVEMENT PERMIT / AUTHORIZATION TO CONSTRUCT / OPERATION PERMIT / EXISTING SYSTEM INSPECTION

PERMIT # 15185A PIN # 4657-32-8114 DATE 4-1-09

OWNER or APPLICANT VELMA + DONALD McNEELY PHONE: Business 704-622-6261 Home:

OWNER or APPLICANT ADDRESS 413 KELLY ST MOORESVILLE

LOCATION / DIRECTIONS 413 W. CATAWBA AVE.

SUBDIVISION — BLOCK / SECTION — LOT # — LOT AREA .262 AC DESIGN FLOW 240 L.T.A.R. .35

Septic Tank 1000 Gallons: STB 825 Date 5-15-09
Pump Tank — Gallons: P T — Date —
Pump Make — Model — Serial # —
Nitrification Field No Fields 1 No Lines 3 Linear Feet 172'
Trench Width 36" Max. Trench Bottom Depth 40" Gravel Depth —

☒ New System ☐ Repair ☐ Expansion System Type I (II) III IV V VI
System Description: GRAVITY 25% REDUCTION
Repair System Description: LP- PANEL BLOCK
Maintenance Agreement Required ☐ YES ☒ NO INITIALLY
☒ GRAVITY ☐ PRESSURE


☒ Residence No. Bedrooms 2
☐ Business No. Persons —
☐ Other No. Employees —
☐ Slab ☐ Crawl Space
☐ Basement w/plumbing ☒ Basement w/o plumbing

Water Supply: ☐ Private ☒ Public ☐ Community


Comments / Conditions 1) DRAIN LINES MUST BE MIN 50' FROM CREEK, 15' FROM DROP OFF + 10' FROM PROP LINE
2) CAN USE END CAPS INSTED OF DROP BOXES IF CHAMBERS ARE USED

Comments / Conditions * 40" TRENCH BOTTOM DUE TO GOOD SOIL BEING DEEPER

INITIAL SITE SKETCH

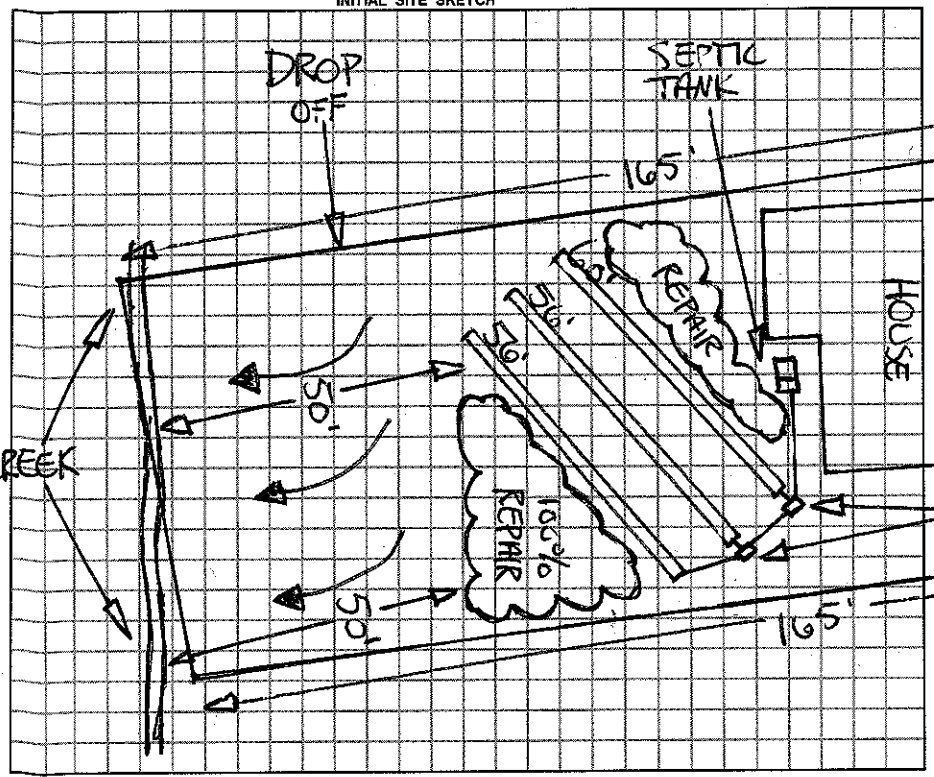

AS BUILT SKETCH

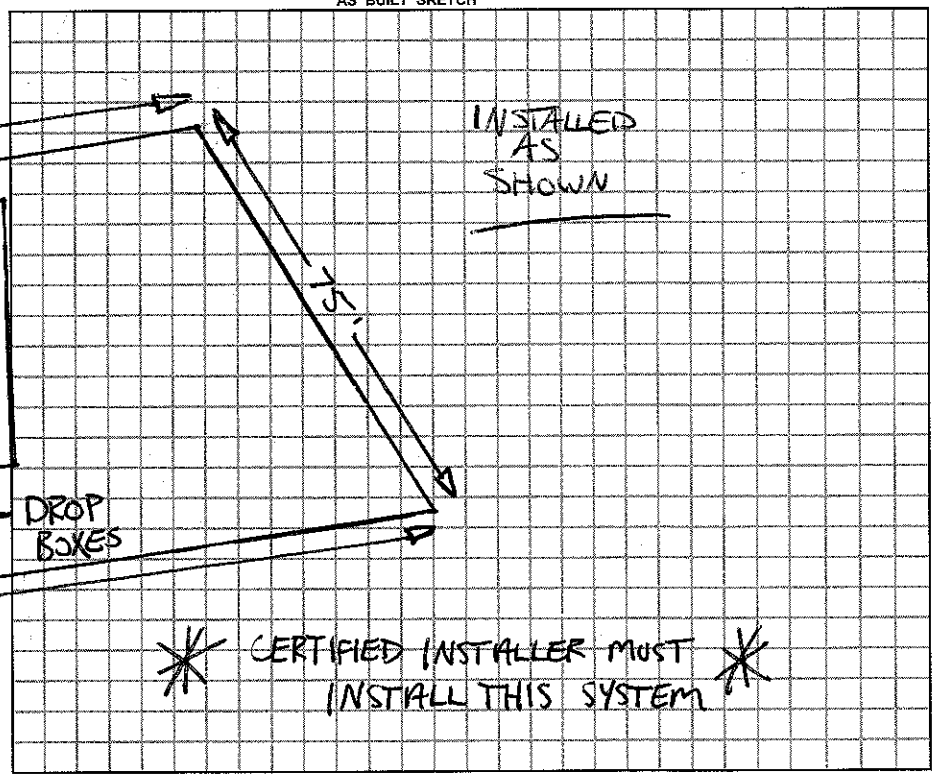

Permit can be suspended or revoked if any false information is supplied toward securing the permit / any unauthorized changes are made to the site / any unauthorized changes are made in the installation of the system.

☐ IMPROVEMENT PERMIT w / plat valid without expiration ☒ IMPROVEMENT PERMIT w / site plan valid for 60 mos.

☒ AUTHORIZATION TO CONSTRUCT valid for period equal to IMPROVEMENT PERMIT-not to exceed 60 mo.

Owner / Applicant Signature: Velma McNeely Date 4-20-09

Improvement Permit by: [signature] Date 4-1-09

Authorization to Construct by: [signature] Date 4-1-09

YOU SHOULD CONTACT A LOCATOR SERVICE PRIOR TO ANY EXCAVATION.

Installed by: JST

Operation Permit by: [signature] RS Date: 7-23-09

Existing System Inspected by: [signature] Date:

WHITE COPY Environmental Health YELLOW COPY (Final) Owner / Applicant PINK COPY (Initial) Owner / Applicant