IREDELL COUNTY HEALTH DEPARTMENT

STATESVILLE 704-878-5305 MOORESVILLE 704-664-5281

IMPROVEMENT PERMIT / ~~CERTIFICATE OF COMPLETION~~ / OPERATION PERMIT / EXISTING SYSTEM INSPECTIO

PROPERTY DESCRIPTION NO. 24597 DATE Oct 9, '97 TAX MAP NO. part of 1145 Watershed: ☑ Yes ☐

OWNER OR CONTRACTOR Bryan Financial Services PHONE: Business 664-3671 Home WSII/PA

ADDRESS 149 Walnut Cove Rd Mooresville NC 4658-00-4820

LOCATION 21 N. TL Valleyview on left At end

SUBDIVISION Oakbrook BLOCK / SECTION LOT 18 LOT AREA .76 AC SITE CLASS. PS DESIGN FLOW 360gpd L.T.A.R. .3

Septic Tank: 1000 Gallons; STB 825 Date 9/19/96

Pump Tank: Gallons; PT 47 Date 8/15/96

Pump Make: Model Serial No.

Nitrification Field: No Fields 1 Square Feet 900 Linear Feet 300

No Lines 4 Trench Width 36" Max Trench Bottom Depth 24" Gravel Depth NA

☑ New System ☐ Repair System Type: I II III IV V VI

System Description: gravity plastic chamhead

Repair System Description: pumped modified OR HDS

Maintenance Agreement Required: ☐ Yes ☑ No

☑ House/Mod. Home No. Bedrooms 3

☐ Mobile Home No. Bathrooms 2

☐ Business No. Employees

☐ Other

☐ Slab ☑ Crawl Space ☐ Basement w/plumbing ☐ Basement wo/plumbing

Water Supply:
☑ Individual
☐ Community
☐ Public


Comments: ~~1~~ ONE inspection/observation port per Lateral

Exit plumbing at existing grade

Comments:

1" = 100'

INITIAL SITE SKETCH

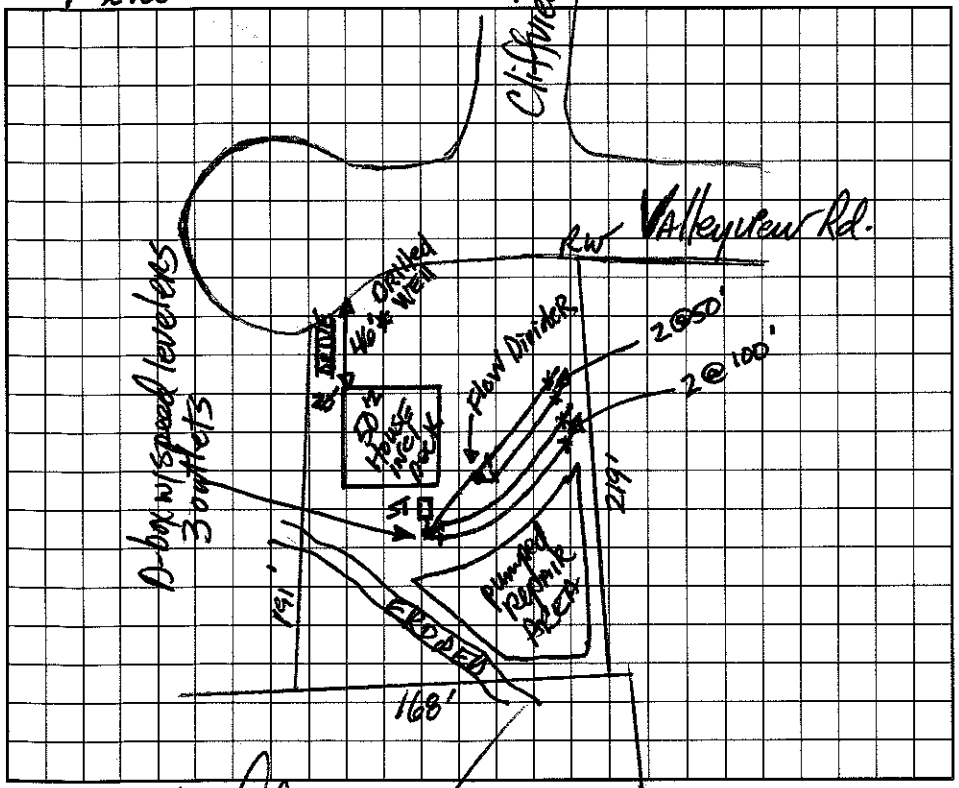

AS BUILT SKETCH

I understand that this permit can be suspended or revoked if any false information is supplied toward securing the permit/any unauthorized changes are made to the site/any unauthorized changes are made in the installation of the system. Improvement Permit is valid for 60 months from date of issuance.

Signed:

Improvement Permit by: D. Huffman RS date 10-9-97

~~Construction~~ Existing System Inspection by: D. Huffman RS date 10-9-97

Installed by: Rowan Septic

Certificate of Completion by: date 11/25/98

Operation Permit by: RS date 11/25/98

HEALTH DEPT. COPY: WHITE INSPECTION COPY (FINAL): GREEN OWNER COPY (FINAL): YELLOW INSPECTION COPY (INITIAL): PINK OWNER COPY (INITIAL): GOLD