(3:30-4:00)

...ELL COUNTY HEALTH DEPARTMENT

STATESVILLE 704-878-5305 MOORESVILLE 704-664-5281

...PROVEMENT PERMIT / CERTIFICATE OF COMPLETION / OPERATION PERMIT / EXISTING SYSTEM INSPECTION

PROPERTY DESCRIPTION NO. 24595 DATE Jan 30, '97 TAX MAP NO. part of 1LA5 Watershed: ☐ Yes ☐ No

OWNER OR CONTRACTOR Kwan Financial Services PHONE: Business 4658-00-6794 Home

ADDRESS 149 Yacht Cove Rd Mooresville

LOCATION US 21N TL Valleyview, on left near end

SUBDIVISION Oakbrook BLOCK / SECTION LOT 16 LOT AREA ±.88Ac SITE CLASS RS DESIGN FLOW 360gpd L.T.A.R. .3

Septic Tank: 1000 Gallons; STB 825 Date 5/11/97

Pump Tank: 1000 Gallons; PT 414 Date 8/11/97

Pump Make: Model Serial No.

Nitrification Field: No Fields 1 Square Feet 1200 Linear Feet 400

No Lines 4@100' Trench Width 36" Max Trench Bottom Depth 24" Gravel Depth 12"

☑ New System ☐ Repair System Type: I, II, (III) IV, V, VI

System Description: pumped conventional

Repair System Description: Same

Maintenance Agreement Required: ☐ Yes ☑ No

☑ House/Mod. Home No. Bedrooms 3

☐ Mobile Home No. Bathrooms 2

☐ Business No. Employees

☐ Other

☐ Slab ☑ Crawl Space ☐ Basement w/plumbing ☐ Basement wo/plumbing


Water Supply: ☑ Individual ☐ Community ☐ Public

Comments:


Comments: NEMATX Bore Alarm Checked 9/24/97

1"=50'

INITIAL SITE SKETCH

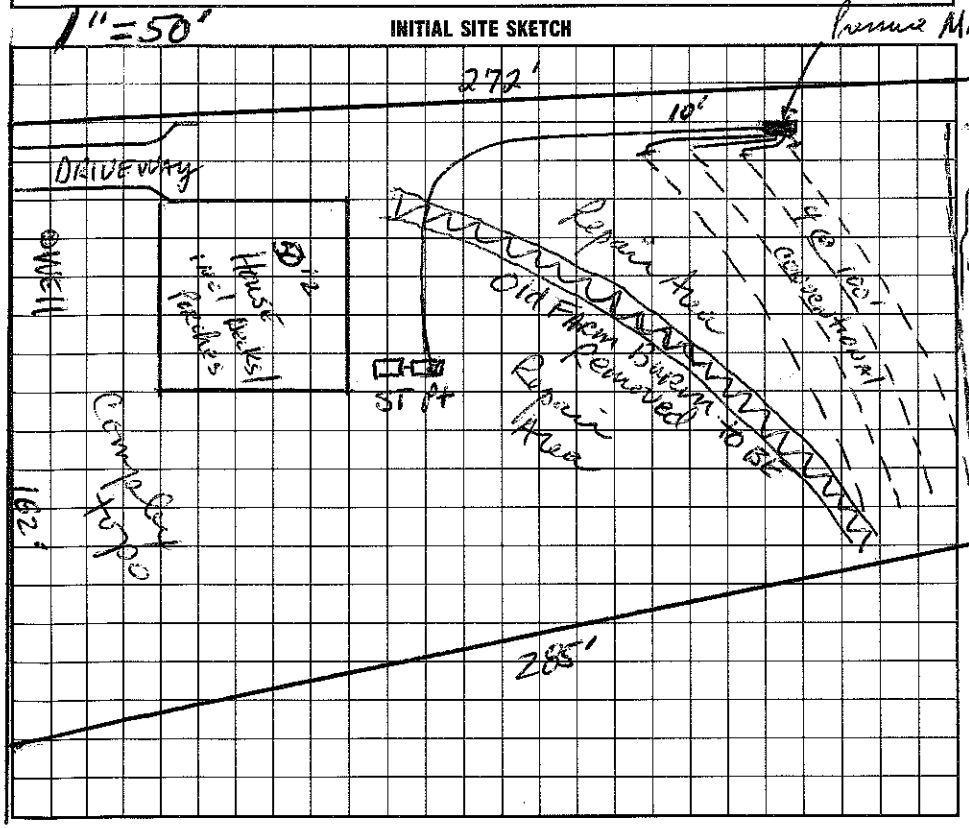

AS BUILT SKETCH

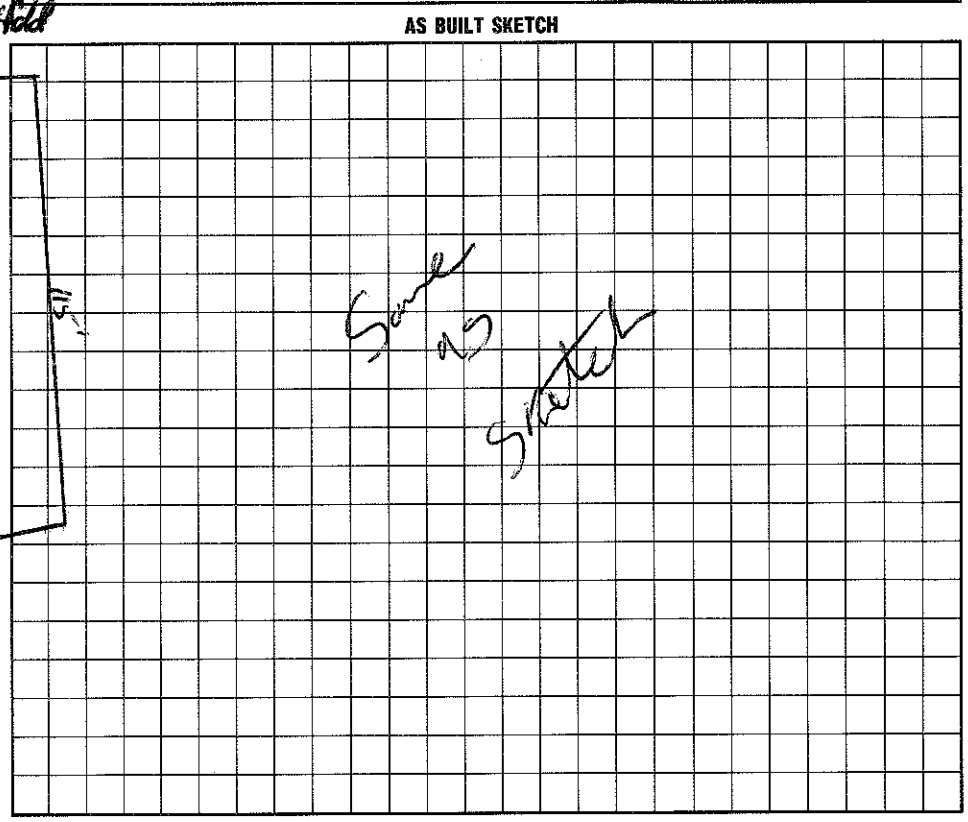

I understand that this permit can be suspended or revoked if any false information is supplied toward securing the permit/any unauthorized changes are made to the site/any unauthorized changes are made in the installation of the system. Improvement Permit is valid for 60 months from date of issuance.

Signed:

Improvement Permit by: Mark R. Hinson, RS date 1-30-97

~~Existing System Inspection by~~ Construction Authorization: J.R. Hinson, RS date 1-30-97

Installed by: ROWAN SEPTIC

Certificate of Completion by: Maria H.H. Dotson date 9/24/97

Operation Permit by: Maria H.H. Dotson date 9/24/97

HEALTH DEPT. COPY: WHITE INSPECTION COPY (FINAL): GREEN OWNER COPY (FINAL): YELLOW INSPECTION COPY (INITIAL): PINK OWNER COPY (INITIAL): GOLD