IREDELL COUNTY HEALTH DEPARTMENT Coastal Auth STATESVILLE 704-878-5305 MOORESVILLE 704-664-5281

(3:30)

IMPROVEMENT PERMIT / ~~CERTIFICATE OF COMPLETION~~ / OPERATION PERMIT / EXISTING SYSTEM INSPECTION

PROPERTY DESCRIPTION NO. 24699 - - DATE Oct 9, '97 TAX MAP NO. part of 1145 4658 01 3160 Watershed: ☑ Yes ☐ No

OWNER OR CONTRACTOR Lion Financial PHONE: Business 664-3671 Home

ADDRESS 149 Yacht Core Rd Mooresville

LOCATION 21 N TL Valleyview TR Cliffview immediately on left PS

SUBDIVISION Oakbrook BLOCK / SECTION LOT 21 LOT AREA 1.2 ac SITE CLASS. PS DESIGN FLOW 360gpd L.T.A.R. .3

Septic Tank: 1000 Gallons; STB 525 Date 12/11/97

Pump Tank: 1000 Gallons; PT 47 Date 12/15/97

Pump Make: Model Serial No.

Nitrification Field: No Fields 1 Square Feet 1200 Linear Feet 400

No Lines 3@133 Trench Width 36" Max Trench Bottom Depth 24" Gravel Depth 12"

☑ New System ☐ Repair System Type: I, II, (III) IV, V, VI

System Description: pumped-dm-conventional

Repair System Description: Same

Maintenance Agreement Required: ☐ Yes ☑ No

☐ Slab ☐ Crawl Space ☑ Basement w/plumbing ☐ Basement wo/plumbing

☑ House/Mod. Home No. Bedrooms 3

☐ Mobile Home No. Bathrooms 3

☐ Business No. Employees

☐ Other


Water Supply:
☑ Individual
☐ Community
☐ Public

Comments:

Comments:

1" = 100'

INITIAL SITE SKETCH

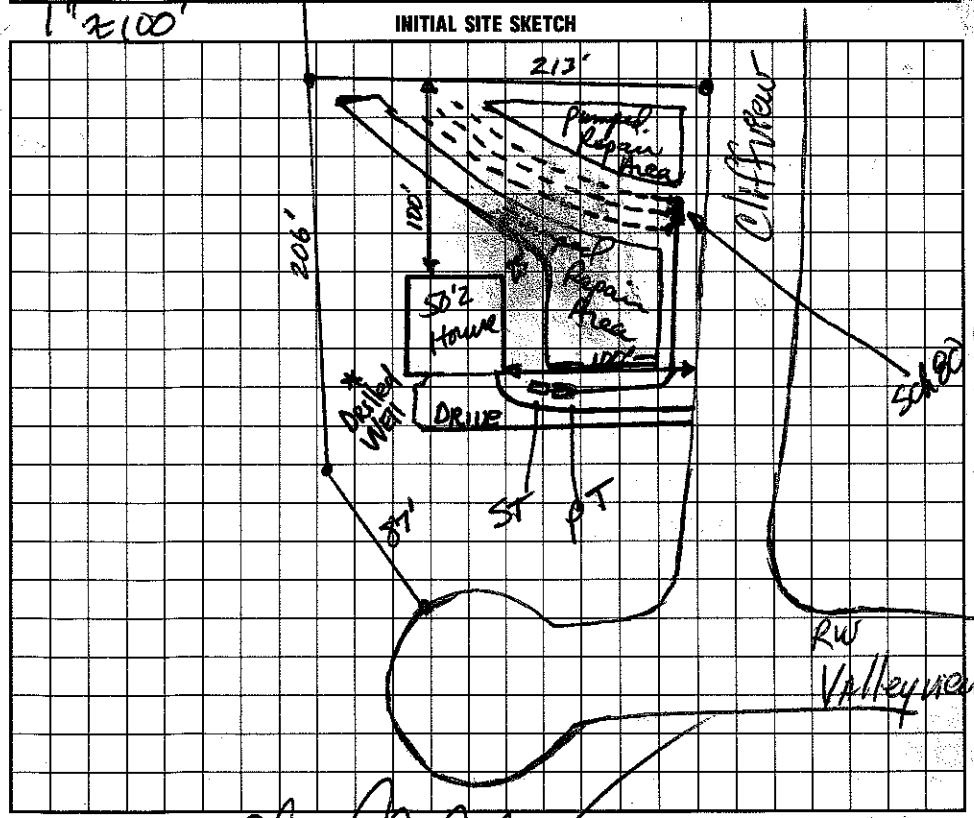

AS BUILT SKETCH

I understand that this permit can be suspended or revoked if any false information is supplied toward securing the permit/any unauthorized changes are made to the site/any unauthorized changes are made in the installation of the system. Improvement Permit is valid for 60 months from date of issuance.

Signed:

Improvement Permit by: date 10-9-97

~~Existing System~~ Construction Inspection by: date 10-9-97

Authorization to

Installed by: ROWAN SEPTIC

Certificate of Completion by: date

Operation Permit by: date 3/12/98

HEALTH DEPT. COPY: WHITE INSPECTION COPY (FINAL): GREEN OWNER COPY (FINAL): YELLOW INSPECTION COPY (INITIAL): PINK OWNER COPY (INITIAL): GOLD