IREDELL COUNTY HEALTH DEPARTMENT Const. Auth. STATESVILLE 704-878-5305 MOORESVILLE 704-664-5281

IMPROVEMENT PERMIT / ~~CERTIFICATE OF COMPLETION~~ / OPERATION PERMIT / EXISTING SYSTEM INSPECTION

PROPERTY DESCRIPTION NO. 24601 DATE April 3, '97 TAX MAP NO. part of 1145 Watershed: ☑ Yes ☐ No

OWNER OR CONTRACTOR Knox Financial Services PHONE: Business ~~Home~~ 4658-01-3380

ADDRESS 149 Yacht Cove Rd., Mooresville

LOCATION I-21 N. TL Valleyview Rd. TR Cliffview 2nd lot on left

SUBDIVISION Oakbrook BLOCK / SECTION ____ LOT 22 LOT AREA .6 AC SITE CLASS. PS DESIGN FLOW 360gpd L.T.A.R. ~.3

Septic Tank: 1000 Gallons; STB 325 Date 1/6/97

Pump Tank: ____ Gallons; PT ____ Date ____

Pump Make: ____ Model ____ Serial No. ____

Nitrification Field: No Fields 1 Square Feet 1200 Linear Feet 400

No Lines 4@100' Trench Width 36" Max Trench Bottom Depth (18") Gravel Depth 12"

☑ New System ☐ Repair System Type: I, (II), III, IV, V, VI

System Description: Shallow gravity conventional

Repair System Description: grav pumped conventional

Maintenance Agreement Required: ☐ Yes ☑ No

☑ House/Mod. Home No. Bedrooms 3

☐ Mobile Home No. Bathrooms 2

☐ Business No. Employees ____

☐ Other ____

☐ Slab ☑ Crawl Space ☐ Basement w/plumbing ☐ Basement wo/plumbing


Water Supply: ☑ Individual ☐ Community ☐ Public

Comments:

Comments: 1st LINE FEEDING FIRST - NEXT 3 FEEDING EQUAL - NO SPEED LEVELERS

1"=100'

INITIAL SITE SKETCH

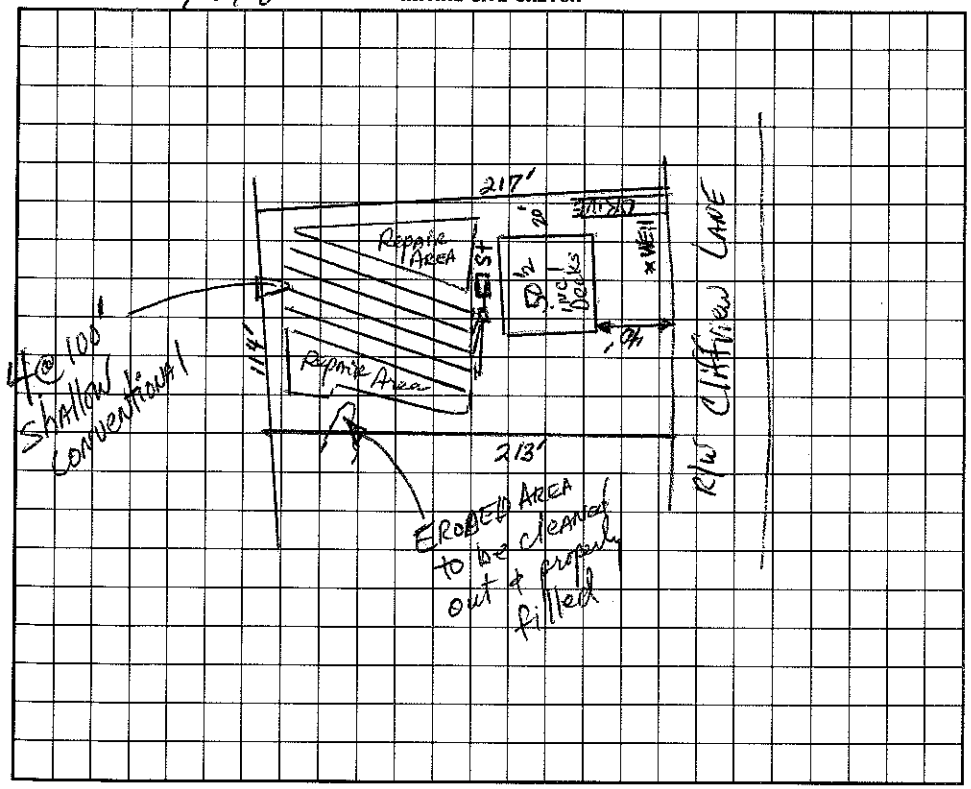

AS BUILT SKETCH

Same as Site Sketch

I understand that this permit can be suspended or revoked if any false information is supplied toward securing the permit/any unauthorized changes are made to the site/any unauthorized changes are made in the installation of the system. Improvement Permit is valid for 60 months from date of issuance.

Signed: ~~X~~

Improvement Permit by: [signature] RS date 4/3/97

~~Existing System Inspection~~ Construction Authorization by: [signature] RS date 4/3/97

Installed by: ROWAN SEPTIC

Certificate of Completion by: ____ date ____

Operation Permit by: [signature] date 5/15/97

HEALTH DEPT. COPY: WHITE INSPECTION COPY (FINAL): GREEN OWNER COPY (FINAL): YELLOW INSPECTION COPY (INITIAL): PINK OWNER COPY (INITIAL): GOLD