IREDELL COUNTY HEALTH DEPARTMENT Const Auth · STATESVILLE 704-878-5305 MOORESVILLE 704-664-5281

IMPROVEMENT PERMIT / ~~CERTIFICATE OF COMPLETION~~ / OPERATION PERMIT / EXISTING SYSTEM INSPECTION

PROPERTY DESCRIPTION NO. 24602 DATE April 21, 1997 TAX MAP NO. part of 12A45 Watershed: ☑ Yes ☐ No

OWNER OR CONTRACTOR Keem Financial Services PHONE: Business Home

ADDRESS 149 Jacob Cope Rd. / Mooresville 4658-01-3492

LOCATION 21 N TL Valley View TR Clifview 3rd lot on left

SUBDIVISION Oakbrook BLOCK / SECTION LOT 23 LOT AREA .6 Ac SITE CLASS PS DESIGN FLOW 360gpd L.T.A.R. .3

Septic Tank: 1000 Gallons; STB 825 Date 9/21/97

Pump Tank: Gallons; PT Date

Pump Make: Model Serial No.

Nitrification Field: No. Fields 1 Square Feet 1200 Linear Feet 400

No. Lines 4 @ 100' Trench Width 36" Max Trench Bottom Depth (18") Gravel Depth 12"

☑ New System ☐ Repair System Type: I, (II), III, IV, V, VI

System Description: Shallow gravity conventional

Repair System Description: Same / pump & cond.

Maintenance Agreement Required: ☐ Yes ☑ No

☑ House/Mod. Home No. Bedrooms 3

☐ Mobile Home No. Bathrooms 2

☐ Business No. Employees

☐ Other

☑ Slab ☐ Crawl Space ☐ Basement w/plumbing ☐ Basement wo/plumbing


Water Supply: ☑ Individual ☐ Community ☐ Public

Comments:

Comments:

1"=50'

INITIAL SITE SKETCH

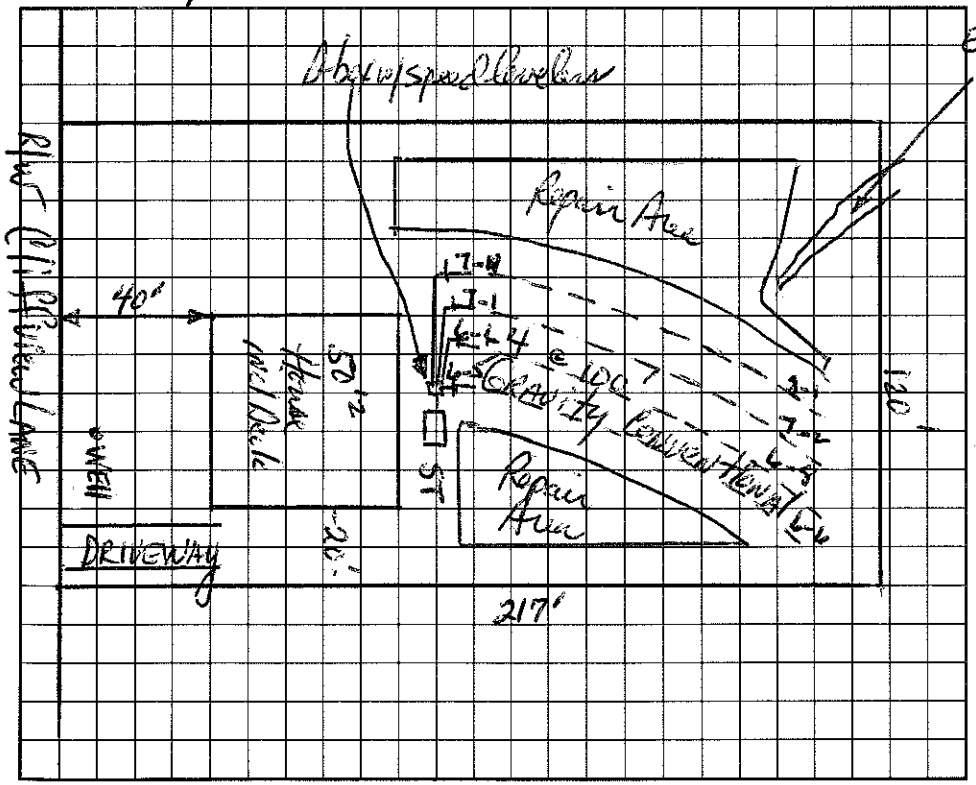

AS BUILT SKETCH

ERODED AREA to be cleaned out & properly filled

I understand that this permit can be suspended or revoked if any false information is supplied toward securing the permit/any unauthorized changes are made to the site/any unauthorized changes are made in the installation of the system. Improvement Permit is valid for 60 months from date of issuance.

Signed:

Improvement Permit by: Marcel R. Hanson RS date 4/21/97

~~Construction~~ Authorization ~~Existing System Inspection by~~: D.J. Hanson, RS date 4/21/97

Installed by: Rowan Septic Tank

Certificate of Completion by: Wesley Sparks RS. date 12/3/97

Operation Permit by: Wesley Sparks RS. date 12/3/97

HEALTH DEPT. COPY: WHITE INSPECTION COPY (FINAL): GREEN OWNER COPY (FINAL): YELLOW INSPECTION COPY (INITIAL): PINK OWNER COPY (INITIAL): GOLD