IREDELL COUNTY HEALTH DEPARTMENT Const. Auth. STATESVILLE 704-878-5305 MOORESVILLE 704-664-5281

IMPROVEMENT PERMIT / ~~CERTIFICATE OF COMPLETION~~ / OPERATION PERMIT / EXISTING SYSTEM INSPECTION

PROPERTY DESCRIPTION NO. 24605 DATE April 8, '97 TAX MAP NO. part of 1LA5 4658 10 3624 Watershed: ☑ Yes ☐ No

OWNER OR CONTRACTOR Krom Financial Services PHONE: Business _____ Home _____

ADDRESS 149 Yacht Cove Rd. Mooresville

LOCATION 2.1 N. 77 Valley view Rd. TR Clifford Ln. on left At end-N-Site

SUBDIVISION Oakbrook BLOCK / SECTION 1 LOT 26 LOT AREA .89AC SITE CLASS. PS DESIGN FLOW 360gpd L.T.A.R. .3

Septic Tank: 1000 Gallons; STB 325 Date 4/12/97

Pump Tank: 1600 Gallons; PT 47 Date MEETS Rec

Pump Make: _____ Model _____ Serial No. _____

Nitrification Field: No Fields 1 Square Feet 900 Linear Feet 300

No Lines 3@100' Trench Width 36" Max Trench Bottom Depth 28 Gravel Depth N/A

☑ New System ☐ Repair System Type: I, II, III, IV, V, VI

System Description: pumped-pm - chambered

Repair System Description: Same / LP Chamber

Maintenance Agreement Required: ☐ Yes ☐ No

☑ House/Mod. Home No. Bedrooms 3

☐ Mobile Home No. Bathrooms 2

☐ Business No. Employees _____

☐ Other _____


☑ Slab ☐ Crawl Space ☐ Basement w/plumbing ☐ Basement wo/plumbing

Water Supply: ☑ Individual ☐ Community ☐ Public

Comments:

Comments: LINES, TANKS, PRESSURE CHECKED 4/21/97

INITIAL SITE SKETCH 1"=100'

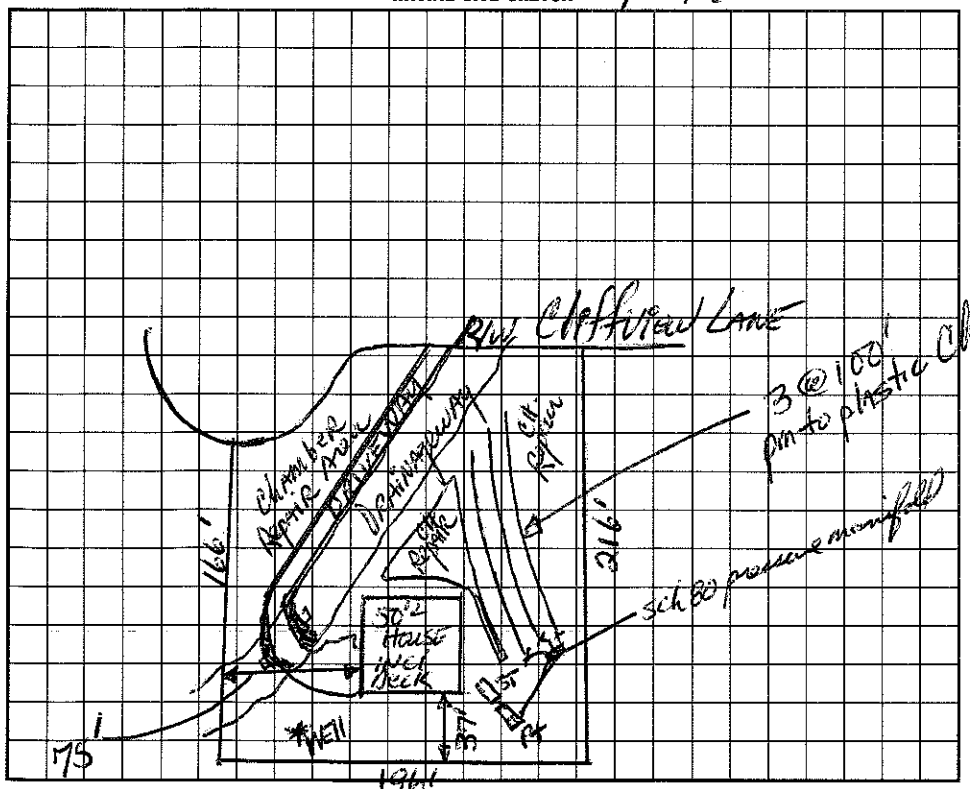

AS BUILT SKETCH

SAME AS SITE SKETCH

I understand that this permit can be suspended or revoked if any false information is supplied toward securing the permit/any unauthorized changes are made to the site/any unauthorized changes are made in the installation of the system. Improvement Permit is valid for 60 months from date of issuance.

Signed: _____

Improvement Permit by: _____ RS date 4-8-97

~~Existing System Inspection by:~~ Construction Authorization by: _____ RS date 4-8-97

Installed by: ROWAN SEPTIC

Certificate of Completion by: _____ date _____

Operation Permit by: _____ date 7-24-97

HEALTH DEPT. COPY: WHITE INSPECTION COPY (FINAL): GREEN OWNER COPY (FINAL): YELLOW INSPECTION COPY (INITIAL): PINK OWNER COPY (INITIAL): GOLD