3:30

IREDELL COUNTY HEALTH DEPARTMENT Const. Auth.

STATESVILLE 704-878-5305 MOORESVILLE 704-664-5281

IMPROVEMENT PERMIT / ~~CERTIFICATE OF COMPLETION~~ / OPERATION PERMIT / EXISTING SYSTEM INSPECTION

PROPERTY DESCRIPTION NO. 24603 DATE April 3, '97 TAX MAP NO. part of 1245 Watershed: ☑ Yes ☐ No

OWNER OR CONTRACTOR Krom Financial Services PHONE: Business Home 4658-01-4504

ADDRESS 149 Yacht Cove Rd, Mooresville

LOCATION 21 N. TL Valleyview TR Cliffview ~4th lot on left

SUBDIVISION Oakbrook BLOCK / SECTION LOT 24 LOT AREA .6ac SITE CLASS. RS DESIGN FLOW 360gpd L.T.A.R. .3

Septic Tank: 1000 Gallons; STB 875 Date 5/1/97

Pump Tank: Gallons; PT Date

Pump Make: Model Serial No.

Nitrification Field: No Fields 1 Square Feet 1200 Linear Feet 400

No Lines 4@100' Trench Width 36" Max Trench Bottom Depth (18") Gravel Depth

☑ New System ☐ Repair System Type: I, II, III, IV, V, VI

System Description: Shallow gravity conventional

Repair System Description: ~~gravity~~ pumped conventional

Maintenance Agreement Required: ☐ Yes ☑ No

☑ House/Mod. Home No. Bedrooms 3

☐ Mobile Home No. Bathrooms 2

☐ Business No. Employees

☐ Other

☑ Slab ☐ Crawl Space ☐ Basement w/plumbing ☐ Basement wo/plumbing


Water Supply: ☑ Individual ☐ Community ☐ Public

Comments:

Comments:

INITIAL SITE SKETCH

1"=100'

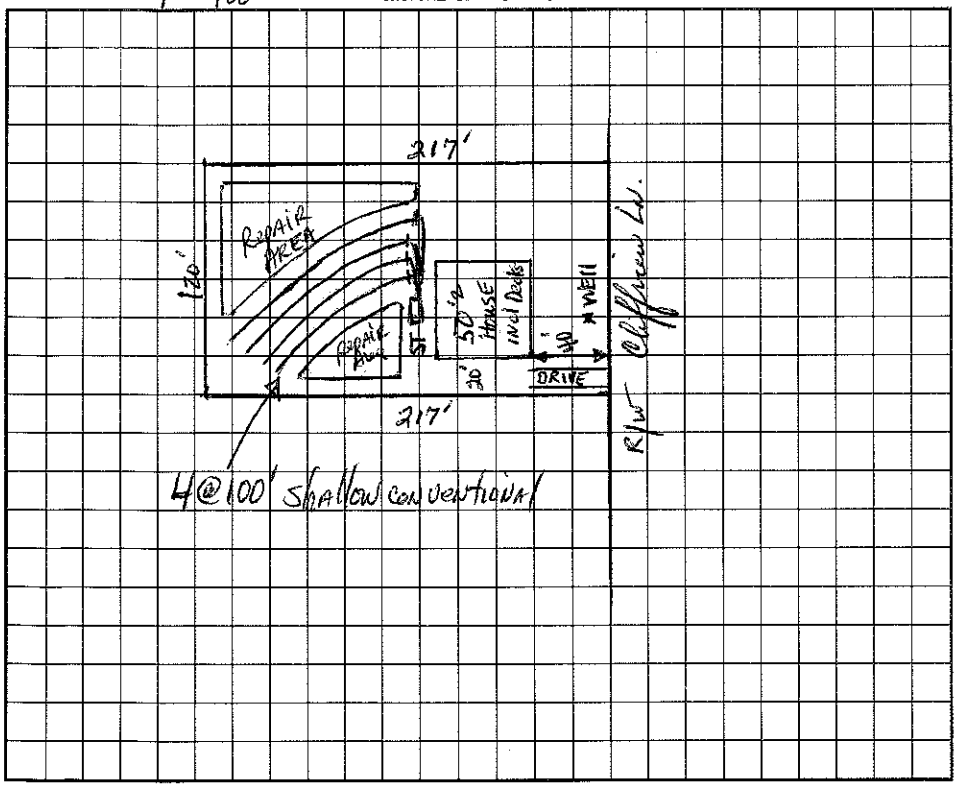

AS BUILT SKETCH

Substantially as shown

I understand that this permit can be suspended or revoked if any false information is supplied toward securing the permit/any unauthorized changes are made to the site/any unauthorized changes are made in the installation of the system. Improvement Permit is valid for 60 months from date of issuance.

Signed:

Improvement Permit by: Wayne Huffman, RS date 4/3/97

~~Existing System Inspection by~~: Wayne Huffman, RS date 4/3/97

Installed by: Rowan Septic

Certificate of Completion by: date

Operation Permit by: C. B. date 6/12/97

HEALTH DEPT. COPY: WHITE INSPECTION COPY (FINAL): GREEN OWNER COPY (FINAL): YELLOW INSPECTION COPY (INITIAL): PINK OWNER COPY (INITIAL): GOLD