(3:30)

IREDELL COUNTY HEALTH DEPARTMENT Const Auth STATESVILLE 704-878-5305 MOORESVILLE 704-664-5281

IMPROVEMENT PERMIT / ~~CERTIFICATE OF COMPLETION~~ / OPERATION PERMIT / EXISTING SYSTEM INSPECTION

PROPERTY DESCRIPTION NO. 24616 DATE April 6, '97 TAX MAP NO. part of 7145 Watershed: ☑ Yes ☐ No

OWNER OR CONTRACTOR Kason Financial Services PHONE: Business ~~Home~~ 4658-01-5083

ADDRESS 149 Yacht Cove Rd, Mooresville, NC

LOCATION 2 N. to Valleyview Rd. on Right corner lot w/ Cliffview Ln.

SUBDIVISION Oakbrook BLOCK / SECTION ____ LOT 37 LOT AREA .66Ac SITE CLASS RS DESIGN FLOW 360 gpd L.T.A.R. 1.3

Septic Tank: 1000 Gallons; STB 825 Date 5/3/97

Pump Tank: ____ Gallons; PT ____ Date ____

Pump Make: ____ Model ____ Serial No. 305

Nitrification Field: No Fields 4 Square Feet 1200 Linear Feet ~~400~~

No Lines 3 Trench Width 36" Max Trench Bottom Depth 24" Gravel Depth 12"

☑ New System ☐ Repair System Type: I, II, III, IV, V, VI

System Description: gravity Conventional

Repair System Description: Same

Maintenance Agreement Required: ☐ Yes ☑ No

☑ House/Mod. Home No. Bedrooms 3

☐ Mobile Home No. Bathrooms 2

☐ Business No. Employees ____

☐ Other ____


☐ Slab ☑ Crawl Space ☐ Basement w/plumbing ☐ Basement wo/plumbing

Water Supply: ☑ Individual ☐ Community ☐ Public

Comments:

Comments: CHANGED TO (CHAMBERED SYSTEM) installed as shown.

INITIAL SITE SKETCH 1" = 100'

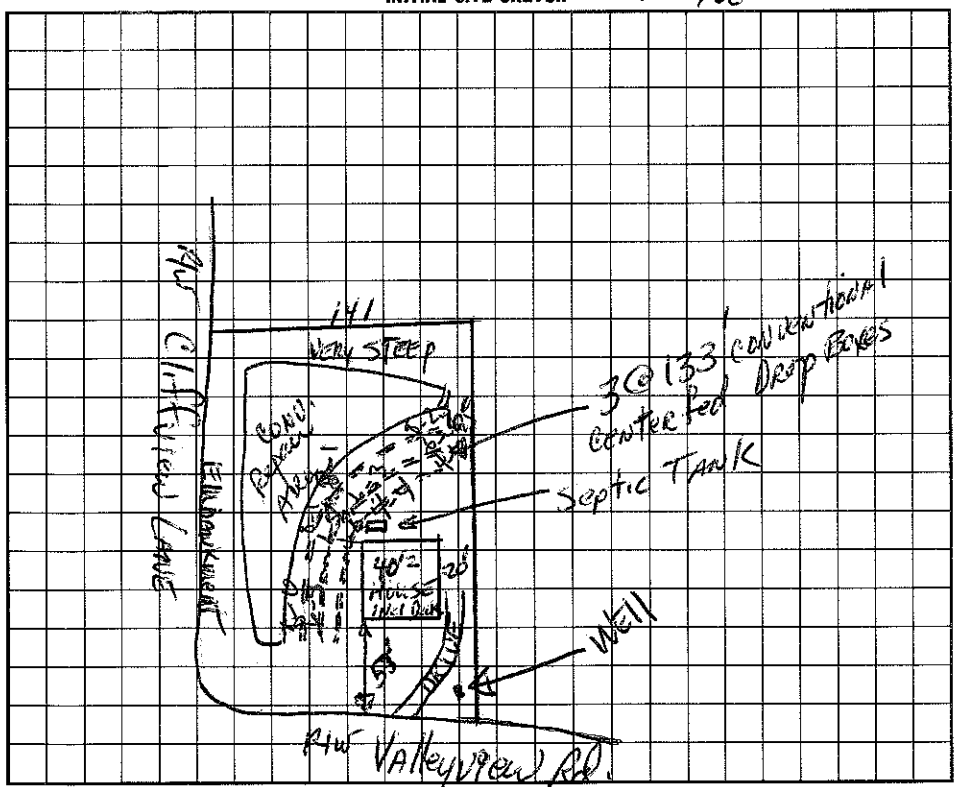

AS BUILT SKETCH

I understand that this permit can be suspended or revoked if any false information is supplied toward securing the permit/any unauthorized changes are made to the site/any unauthorized changes are made in the installation of the system. Improvement Permit is valid for 60 months from date of issuance.

Signed: ____

Improvement Permit by: [signature], RS date 4/8/97

~~Existing System Inspection by:~~ Construction Authorization [signature] RS date 4/8/97

Installed by: Rawson Septic Tank

Certificate of Completion by: Wesley Sparks RS date 6/9/97

Operation Permit by: Wesley Sparks RS date 6/9/97

HEALTH DEPT. COPY: WHITE INSPECTION COPY (FINAL): GREEN OWNER COPY (FINAL): YELLOW INSPECTION COPY (INITIAL): PINK OWNER COPY (INITIAL): GOLD