(3:30-4:00)

IREDELL COUNTY HEALTH DEPARTMENT Const. Auth. STATESVILLE 704-878-5305 MOORESVILLE 704-664-5281

IMPROVEMENT PERMIT / ~~CERTIFICATE OF COMPLETION~~ / OPERATION PERMIT / EXISTING SYSTEM INSPECTION

PROPERTY DESCRIPTION NO. 24615 DATE April 21, '97 TAX MAP NO. part of 12A5 Watershed: ☑ Yes ☐ No

OWNER OR CONTRACTOR Kyon Financial Services PHONE: Business ~~Home~~ 4658-01-6261

ADDRESS 149 Yacht Cove Rd, Mooresville

LOCATION 21 N. TR Valleyview TR Cliffview LN. on Right

SUBDIVISION Oakbrooke BLOCK / SECTION ____ LOT 36 LOT AREA ±.91Ac SITE CLASS. PS DESIGN FLOW 360gpd L.T.A.R. .3

Septic Tank: 1000 Gallons; STB 823 Date 10/7/97

Pump Tank: ____ Gallons; PT 47 Date 12/17/97

Pump Make: ____ Model ____ Serial No. ____

Nitrification Field: No Fields 1 Square Feet 1200 Linear Feet 400

No Lines 3@133' Trench Width 36" Max Trench Bottom Depth 16" Gravel Depth 12"

☑ New System ☐ Repair System Type: I, II, III, IV, V, VI

System Description: pumped - pin - conventional

Repair System Description: 1 Sande

Maintenance Agreement Required: ☐ Yes ☑ No

☑ House/Mod. Home No. Bedrooms 3

☐ Mobile Home No. Bathrooms 2

☐ Business No. Employees ____

☐ Other ____

☐ Slab ☑ Crawl Space ☐ Basement w/plumbing ☐ Basement wo/plumbing

Water Supply: ☑ Individual ☐ Community ☐ Public


Comments:

Comments:


4@100'

1"=50'

INITIAL SITE SKETCH

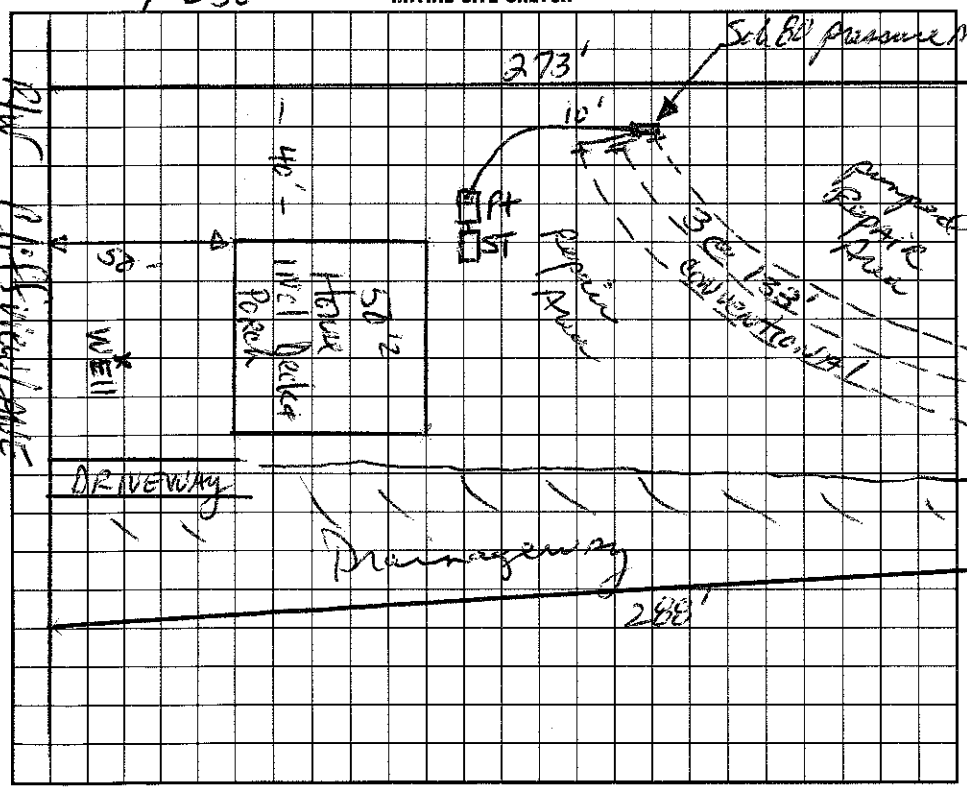

AS BUILT SKETCH

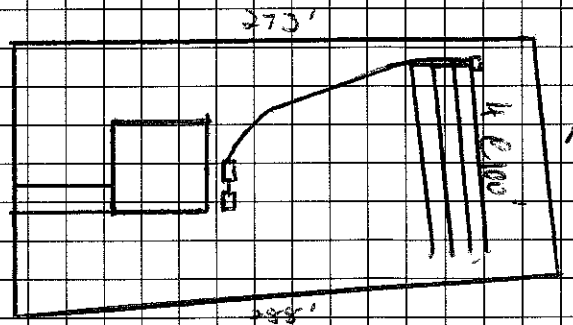

I understand that this permit can be suspended or revoked if any false information is supplied toward securing the permit/any unauthorized changes are made to the site/any unauthorized changes are made in the installation of the system. Improvement Permit is valid for 60 months from date of issuance.

Signed: ____

Improvement Permit by: Mark D. Johnson IRS date 4/21/97

~~Construction~~ Existing System Inspection by: D. Johnson IRS date 4/21/97

Authorization

Installed by: ROWAN SEPTIC

Certificate of Completion by: ____ date ____

Operation Permit by: Brad Lear RS date 2/18/98

HEALTH DEPT. COPY: WHITE INSPECTION COPY (FINAL): GREEN OWNER COPY (FINAL): YELLOW INSPECTION COPY (INITIAL): PINK OWNER COPY (INITIAL): GOLD