IREDELL COUNTY HEALTH DEPARTMENT Const. Auth. STATESVILLE 704-878-5305 MOORESVILLE 704-664-5281

IMPROVEMENT PERMIT / ~~CERTIFICATE OF COMPLETION~~ / OPERATION PERMIT / EXISTING SYSTEM INSPECTION

PROPERTY DESCRIPTION NO. 24614 DATE April 21, 1997 TAX MAP NO. part of 1145 Watershed: ☑ Yes ☐ No

OWNER OR CONTRACTOR Kuon Financial Services PHONE: Business / ~~Home~~ 4658-01-6364

ADDRESS 149 Yacht Cove RD Statesville

LOCATION 21 N. TR Valleyview TR Hillview Ln. on Right

SUBDIVISION Oakbrook BLOCK / SECTION ____ LOT 35 LOT AREA .66Ac SITE CLASS. RS DESIGN FLOW 360gpd L.T.A.R. 1.3

Septic Tank: 1000 Gallons; STB 825 Date 6/5/98

Pump Tank: ____ Gallons; PT ____ Date ____

Pump Make: ____ Model ____ Serial No. ____

Nitrification Field: No Fields 2 Square Feet 1200 Linear Feet 400

No Lines 2+3 Trench Width 36" Max Trench Bottom Depth 16" Gravel Depth 12"

☐ New System ☐ Repair System Type: I, II, III, IV, V, VI

System Description: Shallow gravity conventional

Repair System Description: pumped conventional

Maintenance Agreement Required: ☐ Yes ☑ No

☑ House/Mod. Home No. Bedrooms 3

☐ Mobile Home No. Bathrooms 2

☐ Business No. Employees ____

☐ Other ____

☐ Slab ☑ Crawl Space ☐ Basement w/plumbing ☐ Basement wo/plumbing


Water Supply: ☑ Individual ☐ Community ☐ Public

Comments:


Comments:

1"=50'

INITIAL SITE SKETCH

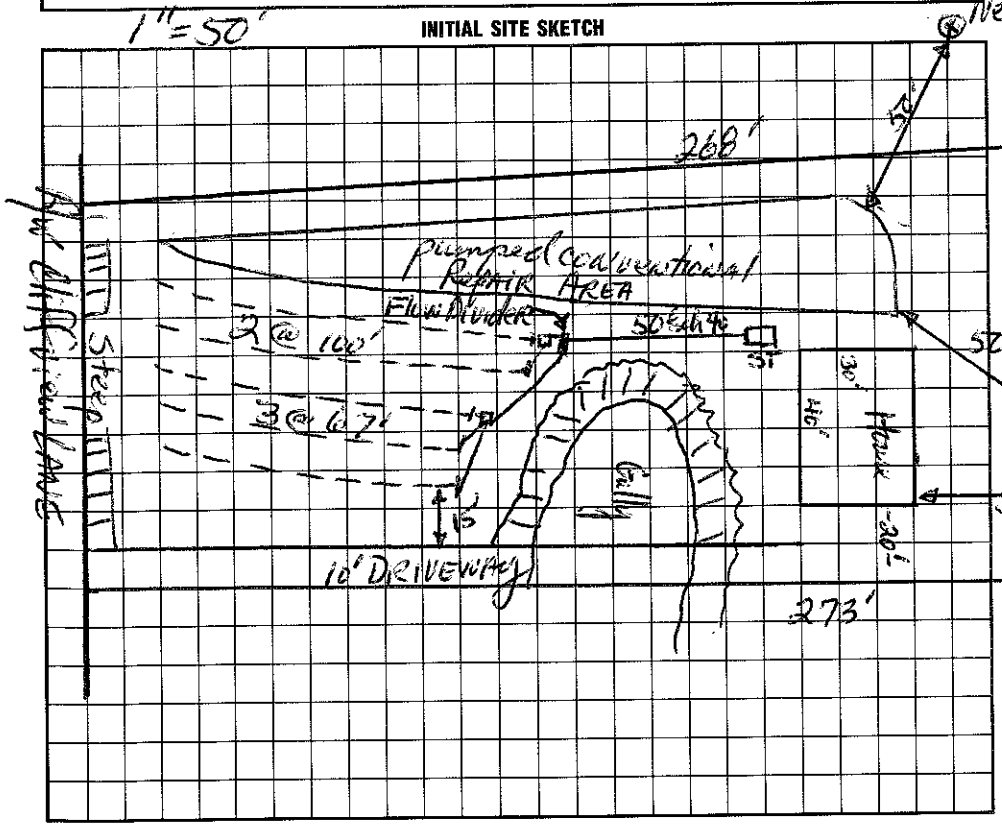

AS BUILT SKETCH

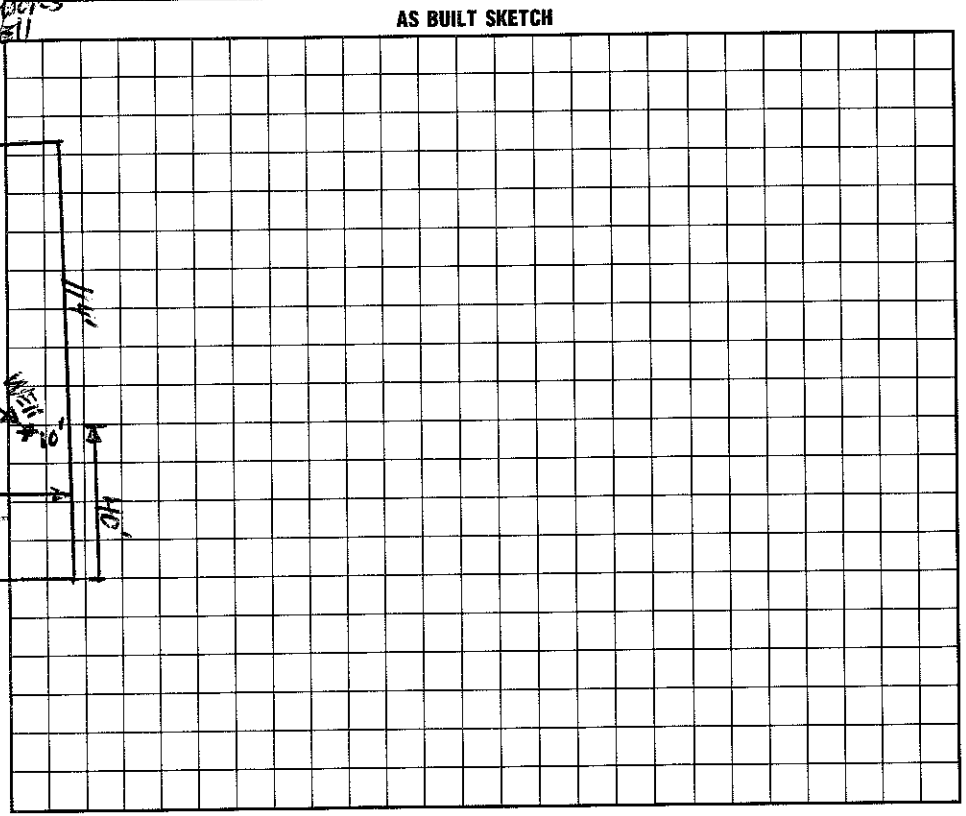

I understand that this permit can be suspended or revoked if any false information is supplied toward securing the permit/any unauthorized changes are made to the site/any unauthorized changes are made in the installation of the system. Improvement Permit is valid for 60 months from date of issuance.

Signed: X

Improvement Permit by: [signature] RS date 4/21/97

Construction ~~Existing System Inspection~~ by: [signature] RS date 4/21/97

Authorization

Installed by: ROWAN SEPTIC

Certificate of Completion by: ____ date ____

Operation Permit by: [signature] RS date 8/16/98

HEALTH DEPT. COPY: WHITE INSPECTION COPY (FINAL): GREEN OWNER COPY (FINAL): YELLOW INSPECTION COPY (INITIAL): PINK OWNER COPY (INITIAL): GOLD