3:00

IREDELL COUNTY HEALTH DEPARTMENT

East Arm STATESVILLE 704-878-5305 MOORESVILLE 704-664-5281

IMPROVEMENT PERMIT / ~~CERTIFICATE OF COMPLETION~~ / OPERATION PERMIT / EXISTING SYSTEM INSPECTION

PROPERTY DESCRIPTION NO. 24613 DATE April 8, '97 TAX MAP NO. part of 1145 Watershed: ☑ Yes ☐ No

OWNER OR CONTRACTOR Kom Financial Services PHONE: Business / ~~Home~~ 4658-01-6464

ADDRESS 149 Yacht Cove Rd, Mooresville NC

LOCATION 2.1 N. of Valleyview Rd to Cliffview Ln. & on Right

SUBDIVISION Cathcart BLOCK / SECTION ____ LOT 34 LOT AREA .74 Ac SITE CLASS B DESIGN FLOW 360gpd L.T.A.R. ~.3

Septic Tank: 1000 Gallons; STB 825 Date 7/13/97

Pump Tank: ____ Gallons; PT ____ Date ____

Pump Make: ____ Model ____ Serial No. ____

Nitrification Field: No Fields 1 Square Feet 1200 Linear Feet 400

No Lines 3 Trench Width 36" Max Trench Bottom Depth 20" Gravel Depth 12"

☑ New System ☐ Repair System Type: I, II, III, IV, V, VI

System Description: gravity conventional

Repair System Description: / same

Maintenance Agreement Required: ☐ Yes ☑ No

☑ House/Mod. Home No. Bedrooms 3

☐ Mobile Home No. Bathrooms 2

☐ Business No. Employees ____

☐ Other ____

☑ Slab ☐ Crawl Space ☐ Basement w/plumbing ☐ Basement wo/plumbing


Water Supply: ☑ Individual ☐ Community ☐ Public

Comments:


Comments:

INITIAL SITE SKETCH

1"=50'

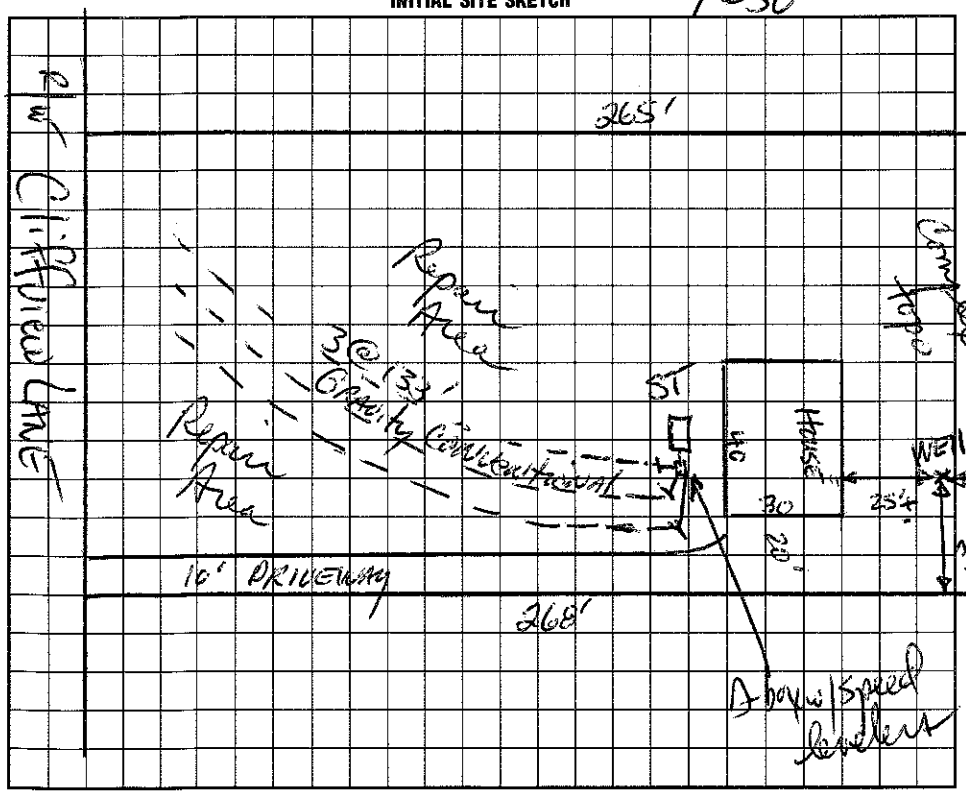

AS BUILT SKETCH

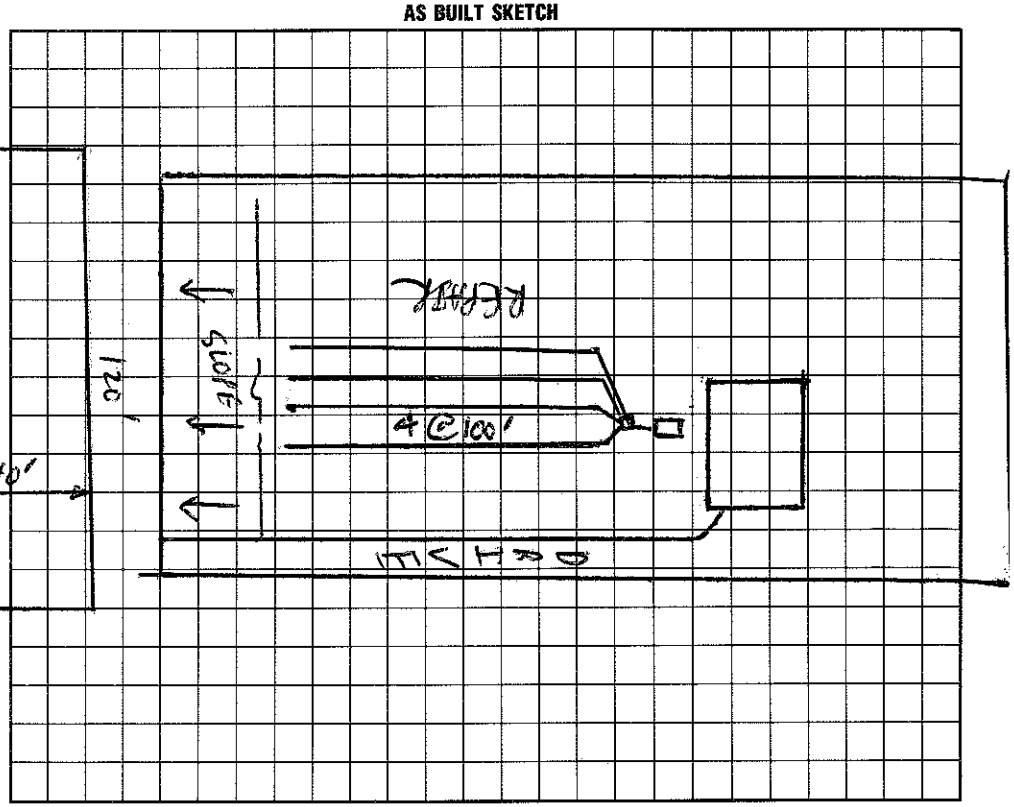

I understand that this permit can be suspended or revoked if any false information is supplied toward securing the permit/any unauthorized changes are made to the site/any unauthorized changes are made in the installation of the system. Improvement Permit is valid for 60 months from date of issuance.

Signed: ____

Improvement Permit by: [signature] date 4/8/97

~~Existing System Inspection by:~~ Construction Authorization [signature] date 4/8/97

Installed by: ROWAN SEPTIC

Certificate of Completion by: ____ date ____

Operation Permit by: C. [signature] date 9/4/97

HEALTH DEPT. COPY: WHITE INSPECTION COPY (FINAL): GREEN OWNER COPY (FINAL): YELLOW INSPECTION COPY (INITIAL): PINK OWNER COPY (INITIAL): GOLD