IREDELL COUNTY HEALTH DEPARTMENT Const. Auth. (4,00)

STATESVILLE 704-878-5305 MOORESVILLE 704-664-5281

IMPROVEMENT PERMIT / ~~CERTIFICATE OF COMPLETION~~ / OPERATION PERMIT / EXISTING SYSTEM INSPECTION

PROPERTY DESCRIPTION NO. 24617 DATE April 22, 97 TAX MAP NO. part of 1245 Watershed: ☑ Yes ☐ No

OWNER OR CONTRACTOR Rowan Financial Services PHONE: Business ~~Home~~ 4658-01-7043

ADDRESS 149 Yacht Cove Rd Mooresville

LOCATION 2 N. TL Valleyview on Right just before Cliffview

SUBDIVISION Oakbrook BLOCK / SECTION LOT 38 LOT AREA .77AC SITE CLASS. RS DESIGN FLOW 360gpd L.T.A.R. .3

Septic Tank: 1000 Gallons; STB 825 Date 5/8/97

Pump Tank: Gallons; PT Date

Pump Make: Model Serial No.

Nitrification Field: No Fields 1 Square Feet 1200 Linear Feet 400

No Lines 4@100' Trench Width 36" Max Trench Bottom Depth (18") Gravel Depth 12"

☑ New System ☐ Repair System Type: I, II, III, IV, V, VI

System Description: Shallow pump conventional

Repair System Description: Same

Maintenance Agreement Required: ☐ Yes ☑ No

☑ House/Mod. Home No. Bedrooms 3

☐ Mobile Home No. Bathrooms 2

☐ Business No. Employees

☐ Other

☑ Slab ☐ Crawl Space ☐ Basement w/plumbing ☐ Basement wo/plumbing


Water Supply: ☑ Individual ☐ Community ☐ Public

Comments:

Comments:

1" = 50'

INITIAL SITE SKETCH

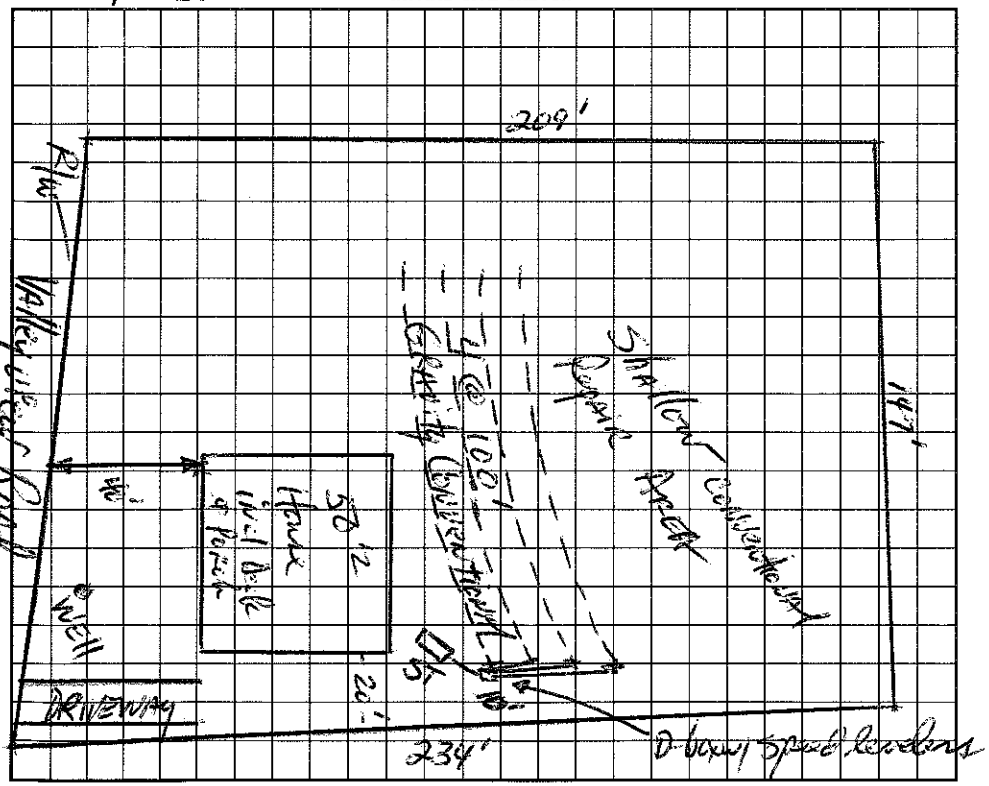

AS BUILT SKETCH

Same as Site Sketch

I understand that this permit can be suspended or revoked if any false information is supplied toward securing the permit/any unauthorized changes are made to the site/any unauthorized changes are made in the installation of the system. Improvement Permit is valid for 60 months from date of issuance.

Signed:

Improvement Permit by: D.R. Hinson, RS date 4/22/97

~~Existing System Inspection by:~~ Construction Authorization D.R. Hinson, RS date 4/22/97

Installed by: ROWAN SEPTIC

Certificate of Completion by: date

Operation Permit by: C. date 7/8/97

HEALTH DEPT. COPY: WHITE INSPECTION COPY (FINAL): GREEN OWNER COPY (FINAL): YELLOW INSPECTION COPY (INITIAL): PINK OWNER COPY (INITIAL): GOLD