IREDELL COUNTY HEALTH DEPARTMENT

Const. Auth. STATESVILLE 704-878-5305 MOORESVILLE 704-664-5281

IMPROVEMENT PERMIT / ~~CERTIFICATE OF COMPLETION~~ / OPERATION PERMIT / EXISTING SYSTEM INSPECTION

PROPERTY DESCRIPTION NO. 24609 DATE April 21, '97 TAX MAP NO. part of 1145 Watershed: ☑ Yes ☐ No

OWNER OR CONTRACTOR Ryan Financial Services PHONE: Business ~~Home~~ 4658-01-7905

ADDRESS 149 Yacht Cove Rd. Mooresville

LOCATION 21 N. to Valleyview TR Cliffview at end on Right

SUBDIVISION Oakbrook BLOCK / SECTION LOT 30 LOT AREA .95Ac SITE CLASS. IS DESIGN FLOW 360gpd L.T.A.R. .3

Septic Tank: 1000 Gallons; STB 825 Date 4/1/98

Pump Tank: Gallons; PT Date

Pump Make: Model Serial No.

Nitrification Field: No Fields 1 Square Feet 1200 Linear Feet 400

No Lines 4 @ 100' Trench Width 36" Max Trench Bottom Depth 24"

☑ New System ☐ Repair System Type: I, II, III, IV, V, VI

System Description: gravity conventional

Repair System Description: same

Maintenance Agreement Required: ☐ Yes ☐ No

Gravel Depth 12"

☑ House/Mod. Home No. Bedrooms 3

☐ Mobile Home No. Bathrooms 2

☐ Business No. Employees

☐ Other


☐ Slab ☑ Crawl Space ☐ Basement w/plumbing ☐ Basement wo/plumbing

Water Supply:
☑ Individual
☐ Community
☐ Public

Comments:

Comments:

INITIAL SITE SKETCH

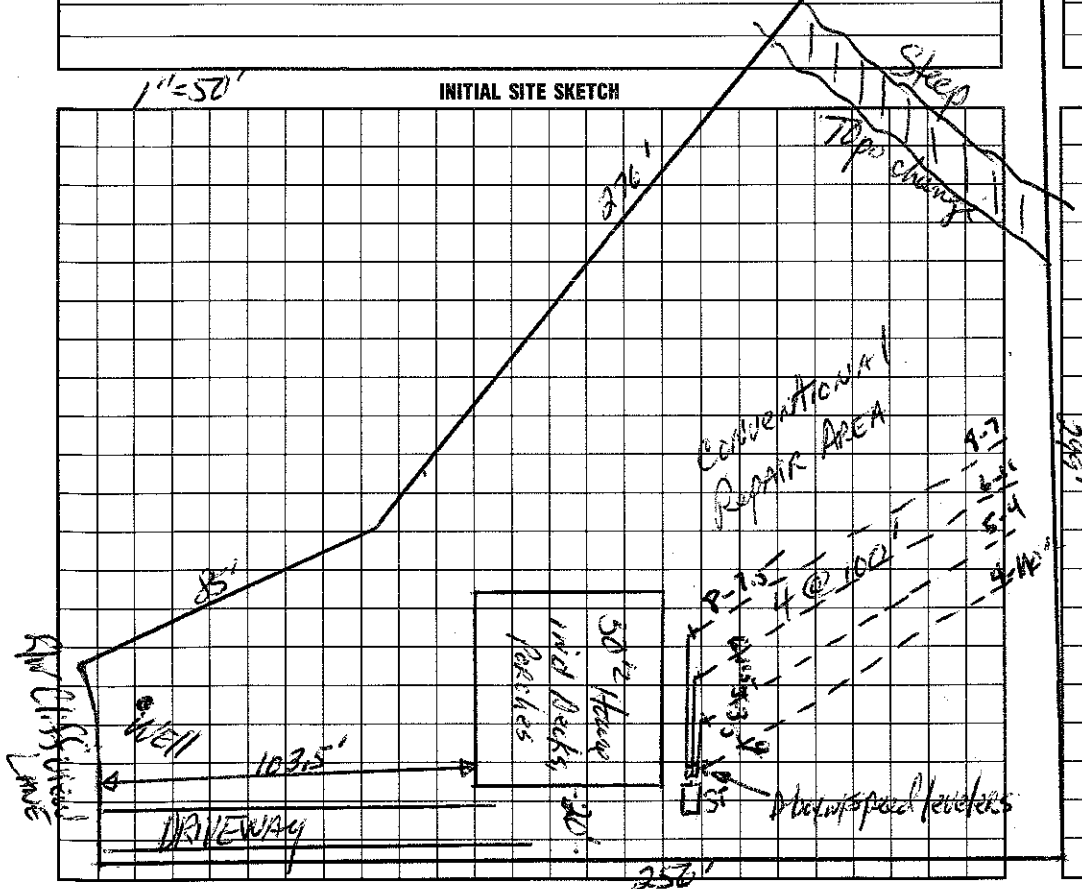

AS BUILT SKETCH

I understand that this permit can be suspended or revoked if any false information is supplied toward securing the permit/any unauthorized changes are made to the site/any unauthorized changes are made in the installation of the system. Improvement Permit is valid for 60 months from date of issuance.

Signed:

Improvement Permit by: D.R. Hanson, RS date 4/21/97

Construction ~~Existing System Inspection by~~: D.R. Hanson, RS date 4/21/97

Authorization

Installed by: Rowan Septic Tanks

Certificate of Completion by: Wesley Sparks RS date 5/12/98

Operation Permit by: Wesley Sparks es. date 5/12/98

HEALTH DEPT. COPY: WHITE INSPECTION COPY (FINAL): GREEN OWNER COPY (FINAL): YELLOW INSPECTION COPY (INITIAL): PINK OWNER COPY (INITIAL): GOLD