IREDELL COUNTY HEALTH DEPARTMENT

STATESVILLE 704-878-5305 MOORESVILLE 704-664-5281

IMPROVEMENT PERMIT / CERTIFICATE OF COMPLETION / OPERATION PERMIT / EXISTING SYSTEM INSPECTION

PROPERTY DESCRIPTION NO. 24620 DATE April 22, '97 TAX MAP NO. part of 1LA5 4658 01 9158 Watershed: ☑ Yes ☐ No

OWNER OR CONTRACTOR Krom Financial Services PHONE: Business _____ Home _____

ADDRESS 149 Yacht Cove Rd Mooresville

LOCATION 21 N. TL Valleyview TR LISHARK 2nd lot on left

SUBDIVISION Oakbrook BLOCK / SECTION _____ LOT 41 LOT AREA .83Ac SITE CLASS PS DESIGN FLOW 360gpd L.T.A.R. .3

Septic Tank: 1000 Gallons; STB 825 Date 11/21/97

Pump Tank: 1000 Gallons; PT 47 Date 1/98

Pump Make: ZOELLER Model N137C Serial No. 2198

Nitrification Field: No Fields ___ Square Feet 1200 Linear Feet 400

No Lines 4 @ 100' Trench Width 36" Max Trench Bottom Depth 18" Gravel Depth 12"

☑ New System ☐ Repair System Type: I, II, III, IV, V, VI

System Description: pumped pin-shallow conventional

Repair System Description: some

Maintenance Agreement Required: ☐ Yes ☑ No

☑ House/Mod. Home No. Bedrooms 3

☐ Mobile Home No. Bathrooms 2

☐ Business No. Employees ___

☐ Other ___


☐ Slab ☑ Crawl Space ☐ Basement w/plumbing ☐ Basement wo/plumbing

Water Supply: ☑ Individual ☐ Community ☐ Public

Comments:

Comments:

INITIAL SITE SKETCH 1"=50'

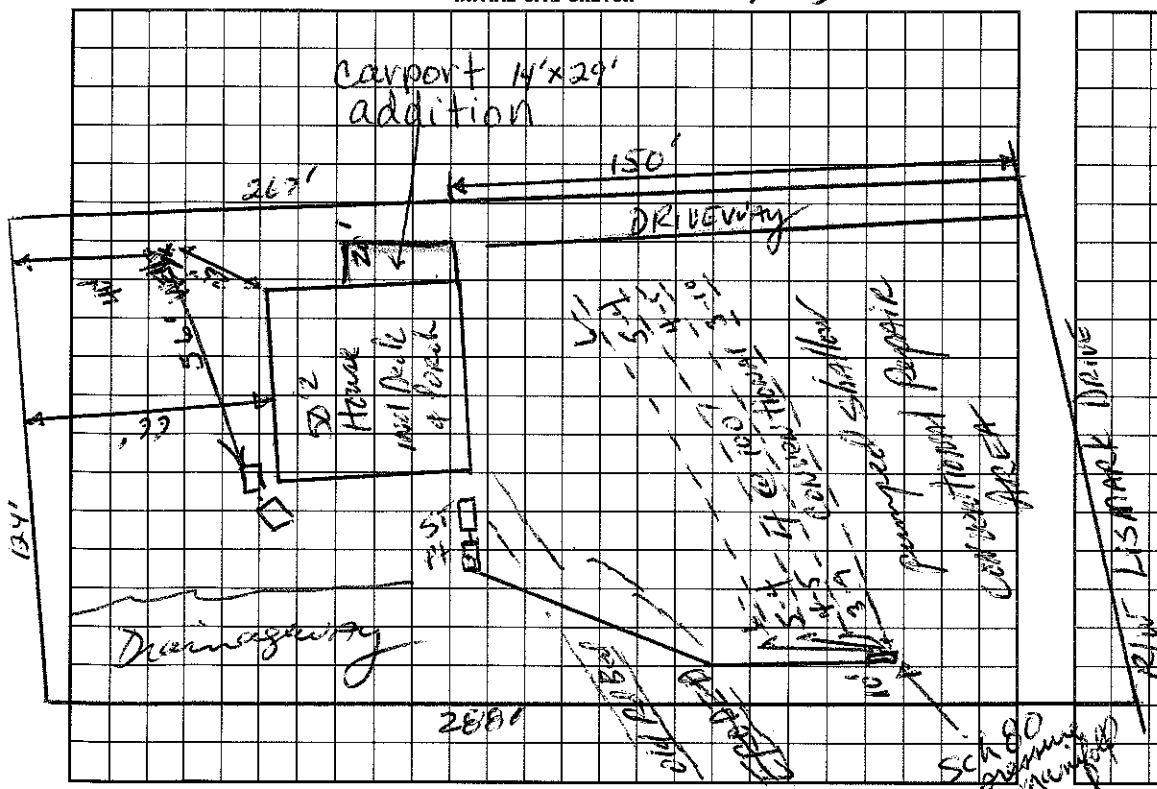

AS BUILT SKETCH

The proposed / existing Carport addition does not appear to impact the existing septic system.

**NOTE: Cannot verify distance to Property Line

Suzy Michelle REHS

Date: 5-17-11

ICHD-Environmental Health Division

I understand that this permit can be suspended or revoked if any false information is supplied toward securing the permit/any unauthorized changes are made to the site/any unauthorized changes are made in the installation of the system. Improvement Permit is valid for 60 months from date of issuance.

Signed: _____

Improvement Permit by: D.E. Hamm, RS date 4/22/97

Construction Existing System Inspection by: D.E. Hamm, RS date 4/22/97

Author: 24 Hour Notice

Installed by: Rowan Septic Tank

Certificate of Completion by: Wesley Sparks R.S. date 4/25/98

Operation Permit by: Wesley Sparks R.S. date 4/29/98

HEALTH DEPT. COPY: WHITE INSPECTION COPY (FINAL): GREEN OWNER COPY (FINAL): YELLOW INSPECTION COPY (INITIAL): PINK OWNER COPY (INITIAL): GOLD