~ 3:00

IREDELL COUNTY HEALTH DEPARTMENT Const. Auth.

STATESVILLE 704-878-5305 MOORESVILLE 704-664-5281

IMPROVEMENT PERMIT / ~~CERTIFICATE OF COMPLETION~~ / OPERATION PERMIT / EXISTING SYSTEM INSPECTION

PROPERTY DESCRIPTION NO. 24621 DATE Jan. 30, '97 TAX MAP NO. part of 1LA5 4658 01 9351 Watershed: ☑ Yes ☐ No

OWNER OR CONTRACTOR Krom Financial Services PHONE: Business / Home

ADDRESS 149 Yacht Cove Rd. Mooresville

LOCATION US21N TL Valleyview TR Lismark on left

SUBDIVISION Oakbrook BLOCK / SECTION LOT 42 LOT AREA ±.72Ac SITE CLASS. PS DESIGN FLOW 360gpd L.T.A.R. .3

Septic Tank: 1000 Gallons; STB 825 Date 8-14-98

Pump Tank: 1000 Gallons; PT 47-1087 Date 8-1-98

Pump Make: Zoeller Model N98 Serial No.

Nitrification Field: No Fields 1 Square Feet 1200 Linear Feet 400

No Lines 3@133' Trench Width 36" Max Trench Bottom Depth 20" Gravel Depth 12"

☑ New System ☐ Repair System Type: I, II, (III), IV, V, VI

System Description: pumped conventional

Repair System Description: Same

Maintenance Agreement Required: ☐ Yes ☑ No

☑ House/Mod. Home No. Bedrooms 3

☐ Mobile Home No. Bathrooms 2

☐ Business No. Employees

☐ Other

☐ Slab ☑ Crawl Space ☐ Basement w/plumbing ☐ Basement wo/plumbing


Water Supply: ☑ Individual ☐ Community ☐ Public

Comments:


Comments: 4-100' lines Installed. Tanks & lines & pressure tested. 9/22/98 JJS

1"=50'

INITIAL SITE SKETCH

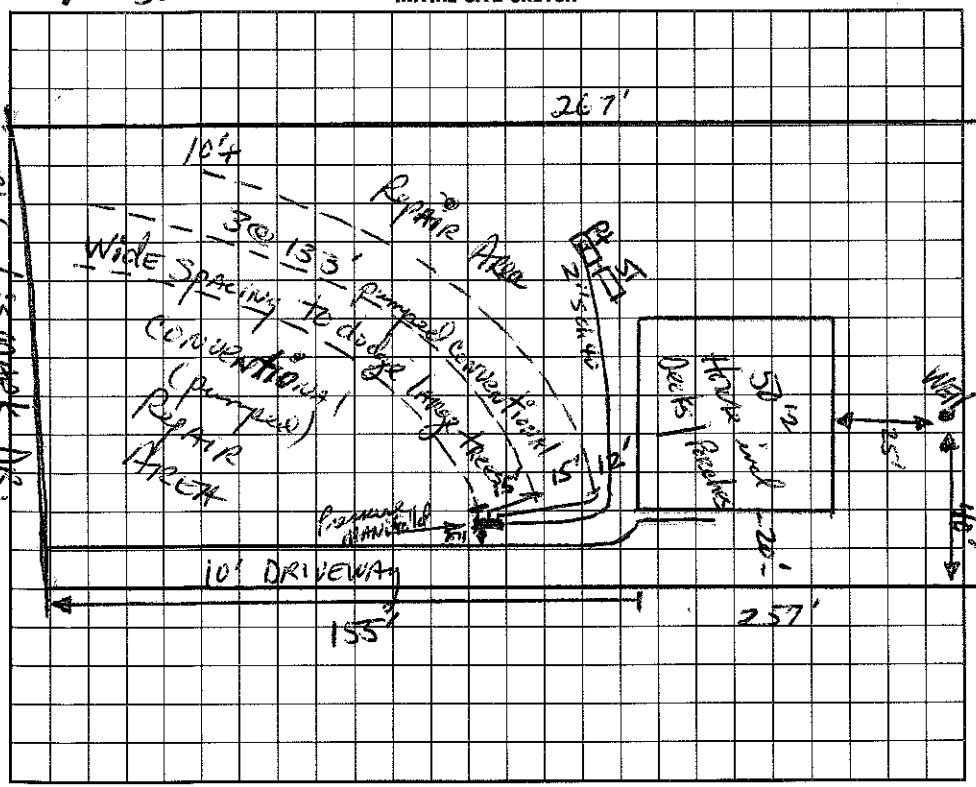

AS BUILT SKETCH

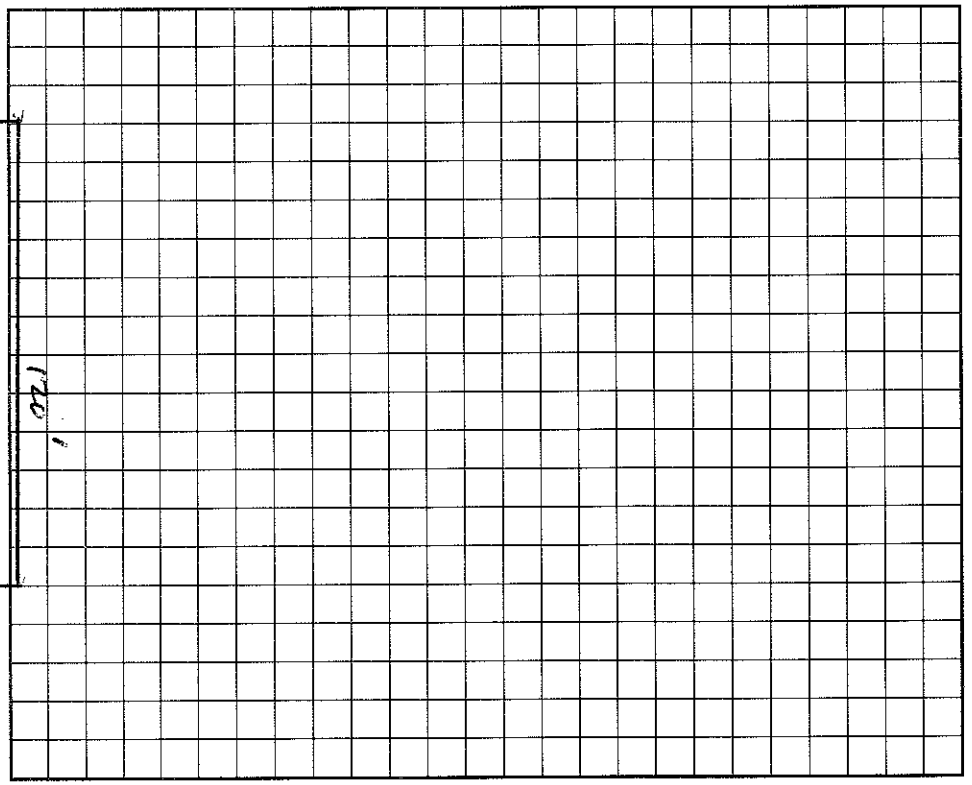

I understand that this permit can be suspended or revoked if any false information is supplied toward securing the permit/any unauthorized changes are made to the site/any unauthorized changes are made in the installation of the system. Improvement Permit is valid for 60 months from date of issuance.

Signed:

Improvement Permit by: , RS date 1-30-97

~~Existing System Inspection by:~~ CONSTRUCTION AUTHORIZATION , RS date 1-30-97

Installed by: Rowan Septic Tanks

Certificate of Completion by: Wesley Sparks RS date 10/7/98

Operation Permit by: Wesley Sparks RS date 10/7/98

HEALTH DEPT. COPY: WHITE INSPECTION COPY (FINAL): GREEN OWNER COPY (FINAL): YELLOW INSPECTION COPY (INITIAL): PINK OWNER COPY (INITIAL): GOLD