IREDELL COUNTY HEALTH DEPARTMENT

STATESVILLE 704-878-5305 MOORESVILLE 704-664-5281

IMPROVEMENT PERMIT / CERTIFICATE OF COMPLETION / OPERATION PERMIT / EXISTING SYSTEM INSPECTION

(4:00)

PROPERTY DESCRIPTION NO. 24622 DATE Jan. 24 '97 TAX MAP NO. part of 1LA5 Watershed: ☑ Yes ☐ No

OWNER OR CONTRACTOR Krom Financial Services PHONE: Business ~~Home~~ 4658-01-9443

ADDRESS 149 Yacht Cove Rd Mooresville

LOCATION US 21 N. TL Valleyview TR Lismark Dr. on left

SUBDIVISION Oakbrook BLOCK / SECTION ____ LOT 43 LOT AREA .75Ac SITE CLASS. P5 DESIGN FLOW 360 gpd L.T.A.R. .3

Septic Tank: 1000 Gallons; STB 825 Date 1/6/97

Pump Tank: ____ Gallons; PT ____ Date ____

Pump Make: ____ Model ____ Serial No. ____

Nitrification Field: No Fields 1 Square Feet 1200 Linear Feet 400

No Lines 4 @ 100' Trench Width 36" Max Trench Bottom Depth 24" Gravel Depth 12"

☑ New System ☐ Repair System Type: I, II, III, IV, V, VI

System Description: gravity conventional

Repair System Description: ____

Maintenance Agreement Required: ☐ Yes ☑ No

☑ House/Mod. Home No. Bedrooms 3

☐ Mobile Home No. Bathrooms 2

☐ Business No. Employees ____

☐ Other ____

☑ Slab ☐ Crawl Space ☐ Basement w/plumbing ☐ Basement wo/plumbing


Water Supply: ☑ Individual ☐ Community ☐ Public

Comments:

Comments:

1"=50'

INITIAL SITE SKETCH

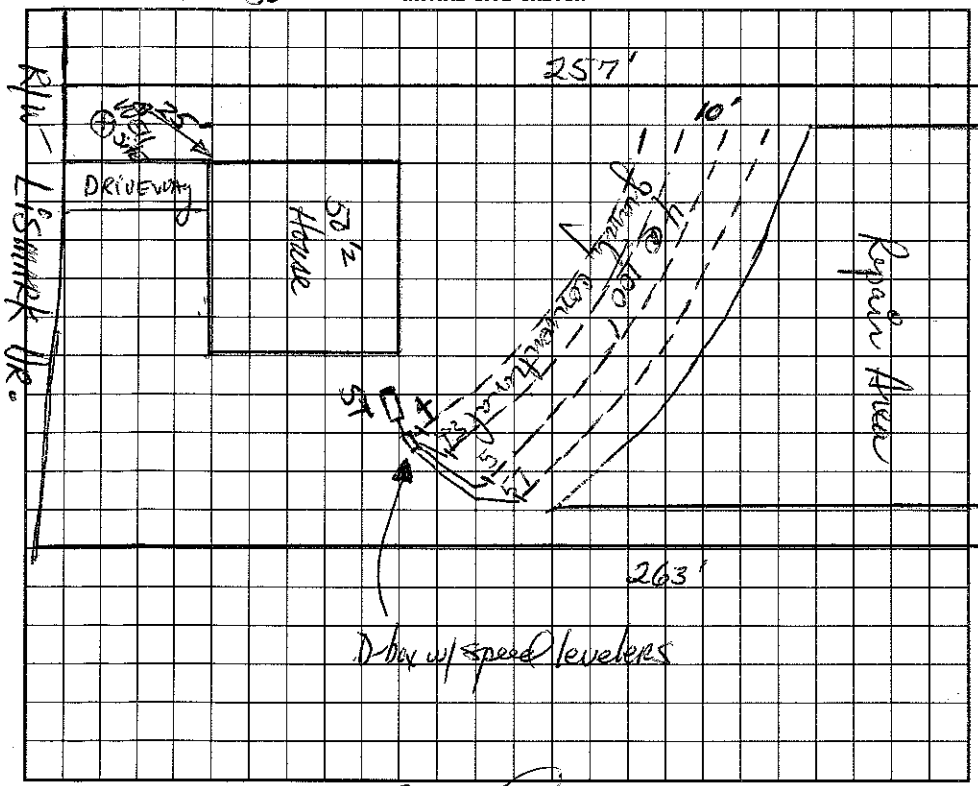

AS BUILT SKETCH

SAME AS SITE SKETCH

I understand that this permit can be suspended or revoked if any false information is supplied toward securing the permit/any unauthorized changes are made to the site/any unauthorized changes are made in the installation of the system. Improvement Permit is valid for 60 months from date of issuance.

Signed: ____

Improvement Permit by: [signature] RS date 1-24-97

~~Existing System Inspection~~ Construction Authorization by: [signature] RS date 1-24-97

Installed by: ROWAN SEPTIC

Certificate of Completion by: ____ date ____

Operation Permit by: [signature] date 4/2/97

HEALTH DEPT. COPY: WHITE INSPECTION COPY (FINAL): GREEN OWNER COPY (FINAL): YELLOW INSPECTION COPY (INITIAL): PINK OWNER COPY (INITIAL): GOLD