(3:30)

IREDELL COUNTY HEALTH DEPARTMENT

Const. Auth STATESVILLE 704-878-5305 MOORESVILLE 704-664-5281

IMPROVEMENT PERMIT / ~~CERTIFICATE OF COMPLETION~~ / OPERATION PERMIT / EXISTING SYSTEM INSPECTION

PROPERTY DESCRIPTION NO. 24623 DATE Jan 24, '97 TAX MAP NO. part of 1LA5 Watershed: ☑ Yes ☐ No

OWNER OR CONTRACTOR Krom Financial Services PHONE: Business ~~Home~~ 4658-01-9545

ADDRESS 149 Yacht Cove Rd. Mooresville

LOCATION US21N TL Valleyview Dr. TR Lismark Dr.

SUBDIVISION Oakbrook BLOCK / SECTION ____ LOT 44 LOT AREA .75Ac SITE CLASS P5 DESIGN FLOW 360gpd L.T.A.R. .3

Septic Tank: 1000 Gallons; STB 825 Date 1/12/97

Pump Tank: ____ Gallons; PT ____ Date ____

Pump Make: ____ Model ____ Serial No. ____

Nitrification Field: No Fields 1 Square Feet 1200 Linear Feet 400

No Lines ~~3 @ 133'~~ Trench Width 36" Max Trench Bottom Depth 30" Gravel Depth 12"

☑ New System ☐ Repair System Type: I, II, III, IV, V, VI

System Description: gravity conventional

Repair System Description: ~~Same~~

Maintenance Agreement Required: ☐ Yes ☑ No

☑ House/Mod. Home No. Bedrooms 3

☐ Mobile Home No. Bathrooms 2

☐ Business No. Employees ____

☐ Other ____

☑ Slab ☐ Crawl Space ☐ Basement w/plumbing ☐ Basement wo/plumbing


Water Supply: ☑ Individual ☐ Community ☐ Public

Comments: 4@100'+3'


Comments: Installed as drawn -

1" = 50'

INITIAL SITE SKETCH

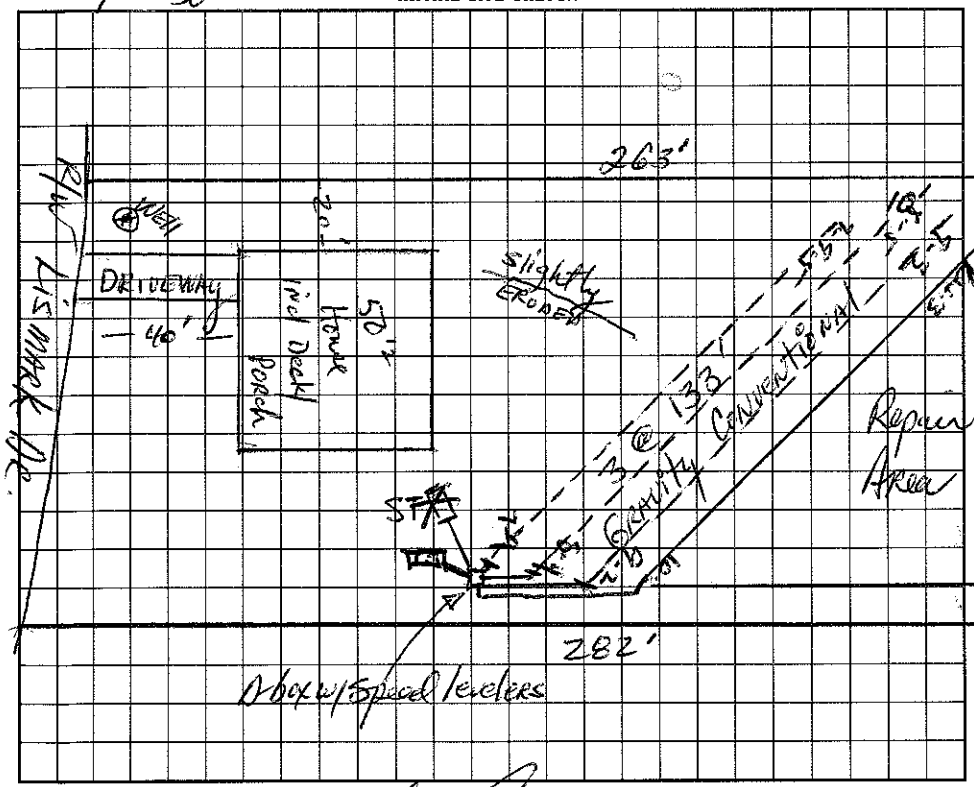

AS BUILT SKETCH

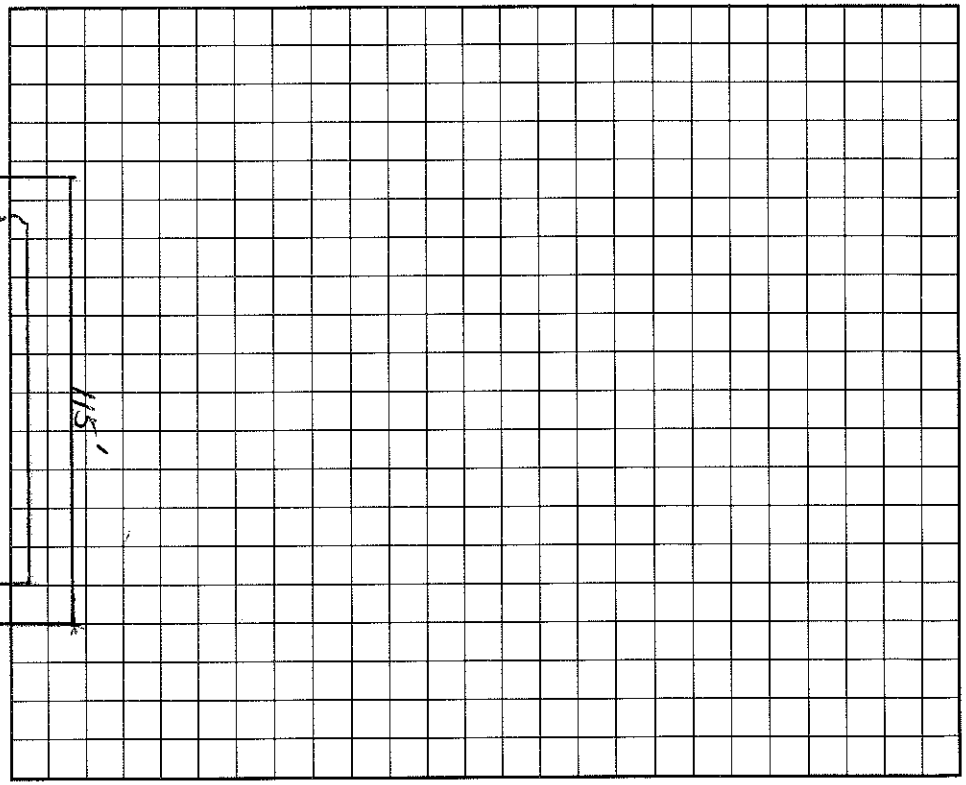

I understand that this permit can be suspended or revoked if any false information is supplied toward securing the permit/any unauthorized changes are made to the site/any unauthorized changes are made in the installation of the system. Improvement Permit is valid for 60 months from date of issuance.

Signed: ____

Improvement Permit by: [signature] RS date 1-24-97

~~Existing System Inspection by:~~ [signature] RS date 1-24-97

Installed by: Rowan Septic Tank

Certificate of Completion by: Wesley Sparks RS date 4/9/97

Operation Permit by: Wesley Sparks RS date 4/9/97

Construction Authorization

HEALTH DEPT. COPY: WHITE INSPECTION COPY (FINAL): GREEN OWNER COPY (FINAL): YELLOW INSPECTION COPY (INITIAL): PINK OWNER COPY (INITIAL): GOLD