(3:00)

IREDELL COUNTY HEALTH DEPARTMENT Const. Auth STATESVILLE 704-878-5305 MOORESVILLE 704-664-5281

IMPROVEMENT PERMIT / ~~CERTIFICATE OF COMPLETION~~ / OPERATION PERMIT / EXISTING SYSTEM INSPECTION

PROPERTY DESCRIPTION NO. 24624 DATE Feb-14-'97 TAX MAP NO. part of 12A5 Watershed: ☑ Yes ☐ No

OWNER OR CONTRACTOR Room Financial Services PHONE: Business ~~Home~~ 4658-01-9656

ADDRESS 149 Yacht Cove Rd. Mooresville

LOCATION 21 N. to Valleyview Rd. TR Lismark Dr. on left at end

SUBDIVISION Oakbrook BLOCK / SECTION ____ LOT 45 LOT AREA .75 Ac SITE CLASS. RS DESIGN FLOW 360gpd L.T.A.R. .3

Septic Tank: 1000 Gallons; STB ____ Date ____

Pump Tank: ____ Gallons; PT ____ Date ____

Pump Make: ____ Model ____ Serial No. ____

Nitrification Field: No Fields 1 Square Feet 1200 Linear Feet 400

No Lines 4@100' Trench Width 36" Max Trench Bottom Depth 18" Gravel Depth 12"

☑ New System ☐ Repair System Type: I, II, III, IV, V, VI

System Description: Shallow gravity conventional

Repair System Description: same

Maintenance Agreement Required: ☐ Yes ☑ No

☑ House/Mod. Home No. Bedrooms 3

☐ Mobile Home No. Bathrooms 2

☐ Business No. Employees ____

☐ Other ____

☑ Slab ☐ Crawl Space ☐ Basement w/plumbing ☐ Basement wo/plumbing


Water Supply:
☑ Individual
☐ Community
☐ Public

Comments: 6@0
6@9
6@9
5@9


Comments:

1" = 100'

INITIAL SITE SKETCH

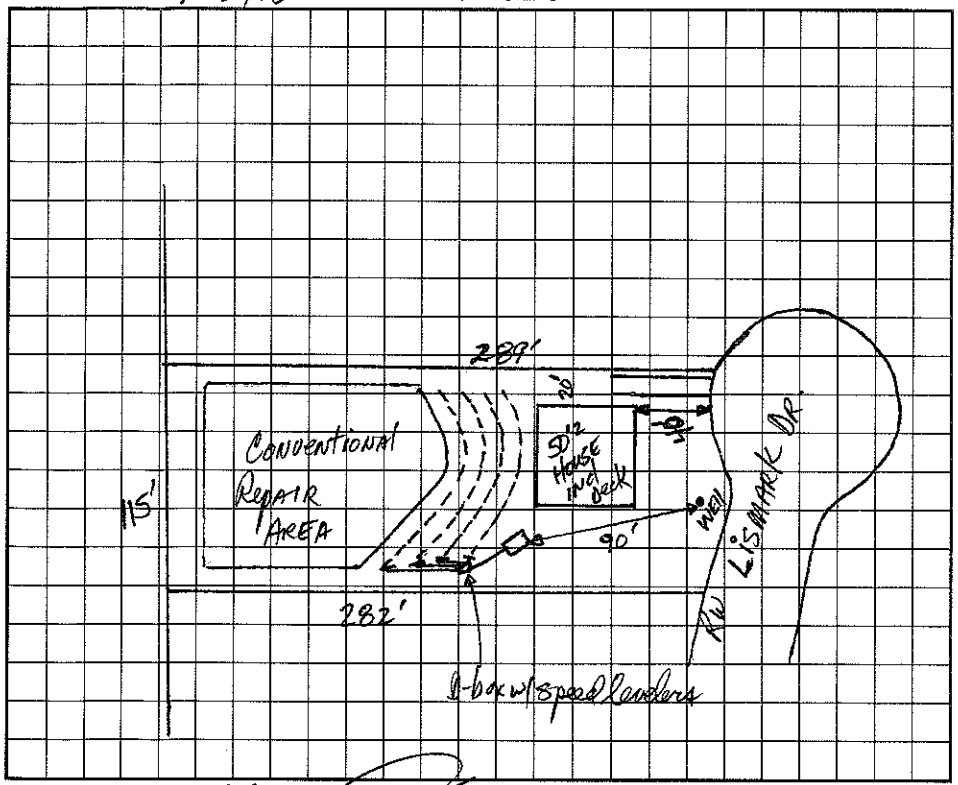

AS BUILT SKETCH

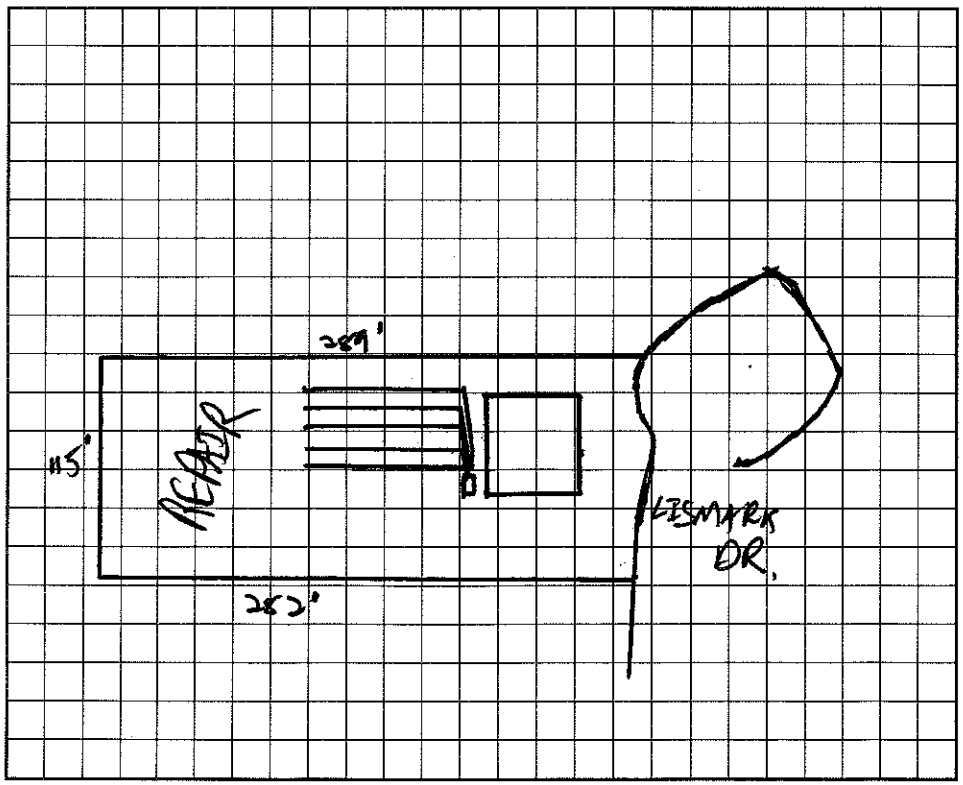

I understand that this permit can be suspended or revoked if any false information is supplied toward securing the permit/any unauthorized changes are made to the site/any unauthorized changes are made in the installation of the system. Improvement Permit is valid for 60 months from date of Issuance.

Signed: ____

Improvement Permit by: [signature] RS date 2-14-97

~~Construction~~ ~~Existing System Inspection by:~~ [signature] RS date 3-14-97

Installed by: Rowan Septic

Certificate of Completion by: ____ date ____

Operation Permit by: [signature] RS date 2/2/98

~~Authorization~~

HEALTH DEPT. COPY: WHITE INSPECTION COPY (FINAL): GREEN OWNER COPY (FINAL): YELLOW INSPECTION COPY (INITIAL): PINK OWNER COPY (INITIAL): GOLD