(3,800)

IREDELL COUNTY HEALTH DEPARTMENT Cons/Auth STATESVILLE 704-878-5305 MOORESVILLE 704-664-5281

IMPROVEMENT PERMIT / ~~CERTIFICATE OF COMPLETION~~ / OPERATION PERMIT / EXISTING SYSTEM INSPECT.

PROPERTY DESCRIPTION NO. 24606 DATE Oct 9, '97 TAX MAP NO. part of 1145 Watershed: ☑ Yes ☐ No

OWNER OR CONTRACTOR Kim Swanfigal PHONE: Business 664-3671 ~~Home~~ 4658-02-3330

ADDRESS 149 Yacht Cove Rd Mooresville

LOCATION 12 IN. TL Valleyview TR Cliffview AT END PS

SUBDIVISION Oakbrook BLOCK / SECTION ____ LOT 27 LOT AREA 1.76 Ac SITE CLASS. ____ DESIGN FLOW 360gpd L.T.A.R. .3

Septic Tank: 1000 Gallons; STB 825 Date 10/30/97

Pump Tank: ____ Gallons; PT ____ Date ____

Pump Make: ____ Model ____ Serial No. ____

Nitrification Field: No Fields 1 Square Feet 1200 Linear Feet 400

No Lines 4@100' Trench Width 36" Max Trench Bottom Depth ____ Gravel Depth ____

☑ New System ☐ Repair System Type: I, ☐ II, III, IV, V, VI

System Description: gravity Conventional

Repair System Description: Same

Maintenance Agreement Required: ☐ Yes ☑ No

☑ House/Mod. Home No. Bedrooms 3

☐ Mobile Home No. Bathrooms 2

☐ Business No. Employees ____

☐ Other ____


☑ Slab ☐ Crawl Space ☐ Basement w/plumbing ☐ Basement wo/plumbing

Water Supply: ☑ Individual ☐ Community ☐ Public


Comments: 51
510
72
86

Comments:

INITIAL SITE SKETCH

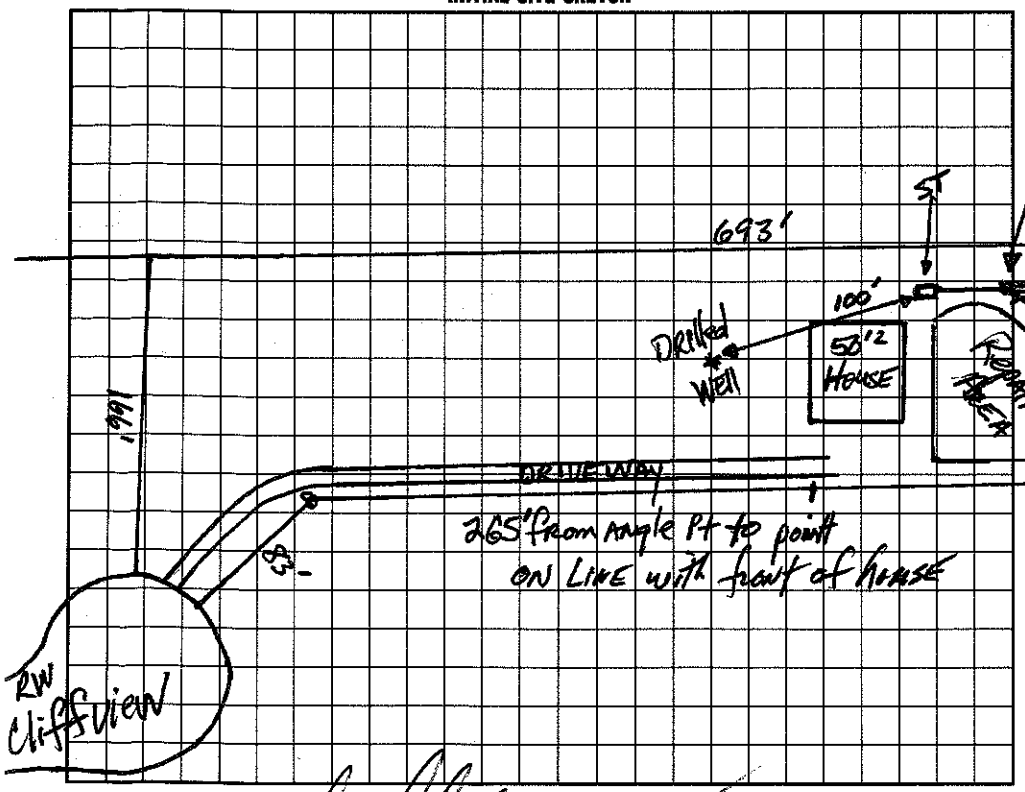

AS BUILT SKETCH

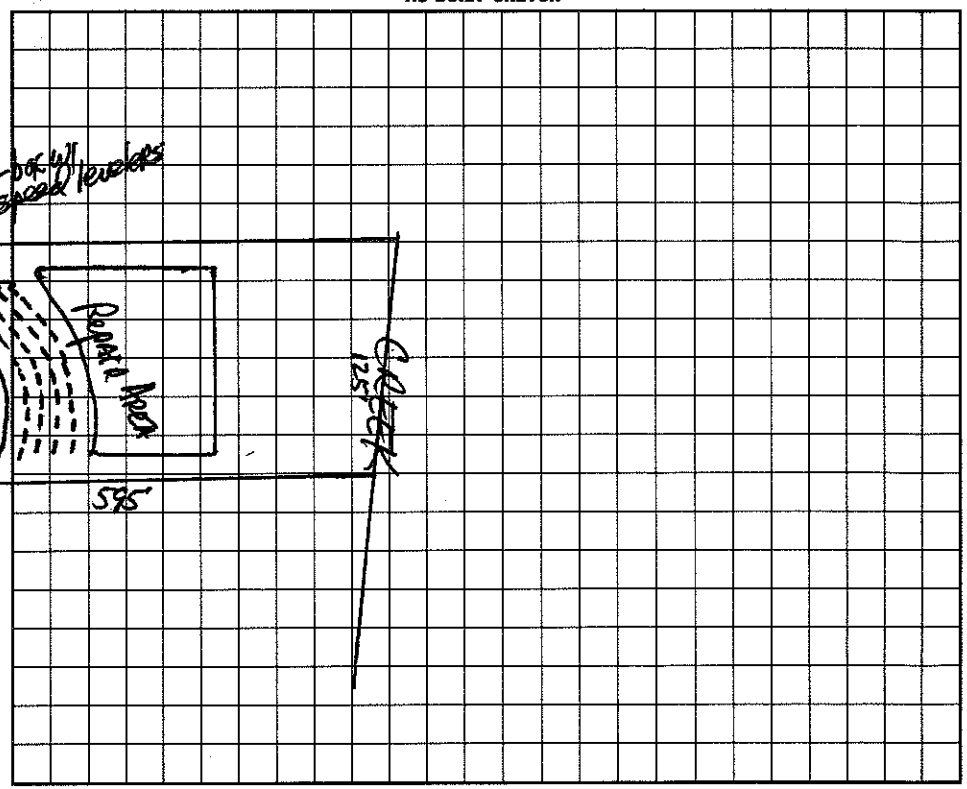

I understand that this permit can be suspended or revoked if any false information is supplied toward securing the permit/any unauthorized changes are made to the site/any unauthorized changes are made in the installation of the system. Improvement Permit is valid for 60 months from date of issuance.

Signed: ____

Improvement Permit by: DR Hanson RS date 10-9-97

~~Construction System Inspection~~ Authorization by: DR Hanson RS date 10-9-97

Installed by: ROWAN SEPTIC

Certificate of Completion by: ____ date ____

Operation Permit by: C. [illegible] date 1/29/98

HEALTH DEPT. COPY: WHITE INSPECTION COPY (FINAL): GREEN OWNER COPY (FINAL): YELLOW INSPECTION COPY (INITIAL): PINK OWNER COPY (INITIAL): GOLD