IREDELL COUNTY HEALTH DEPARTMENT Const. Auth. · STATESVILLE 704-878-5305 MOORESVILLE 704-664-5281

IMPROVEMENT PERMIT / ~~CERTIFICATE OF COMPLETION~~ / OPERATION PERMIT / EXISTING SYSTEM INSPECTION

PROPERTY DESCRIPTION NO. 24607 DATE April 16, '97 TAX MAP NO. part of 1LA5 Watershed: ☑ Yes ☐ No

OWNER OR CONTRACTOR Kyan Financial Services PHONE: Business / ~~Home~~ 4658-02-4370

ADDRESS 149 Yacht Cove Rd Mooresville

LOCATION 2 I N. TL Valleyview TR Cliffview AT END

SUBDIVISION Oak Brook BLOCK / SECTION LOT 28 LOT AREA 1.92 Ac SITE CLASS. PS DESIGN FLOW 360gpd L.T.A.R. .3

Septic Tank: 1000 Gallons; STB 825 Date 1/2/98

Pump Tank: Gallons; PT Date

Pump Make: Model Serial No.

Nitrification Field: No Fields 1 Square Feet 1200 Linear Feet 400

No Lines 2 Trench Width 36" Max Trench Bottom Depth 18"

☑ New System ☐ Repair System Type: I, II, III, IV, V, VI

System Description: Shallow Conventional

Repair System Description: Same

Maintenance Agreement Required: ☐ Yes ☑ No

Gravel Depth 12"

☑ House/Mod. Home No. Bedrooms 3

☐ Mobile Home No. Bathrooms 2

☐ Business No. Employees

☐ Other

☑ Slab ☐ Crawl Space ☐ Basement w/plumbing ☐ Basement wo/plumbing


Water Supply: ☑ Individual ☐ Community ☐ Public

Comments:

Comments:

1" = 100'

INITIAL SITE SKETCH

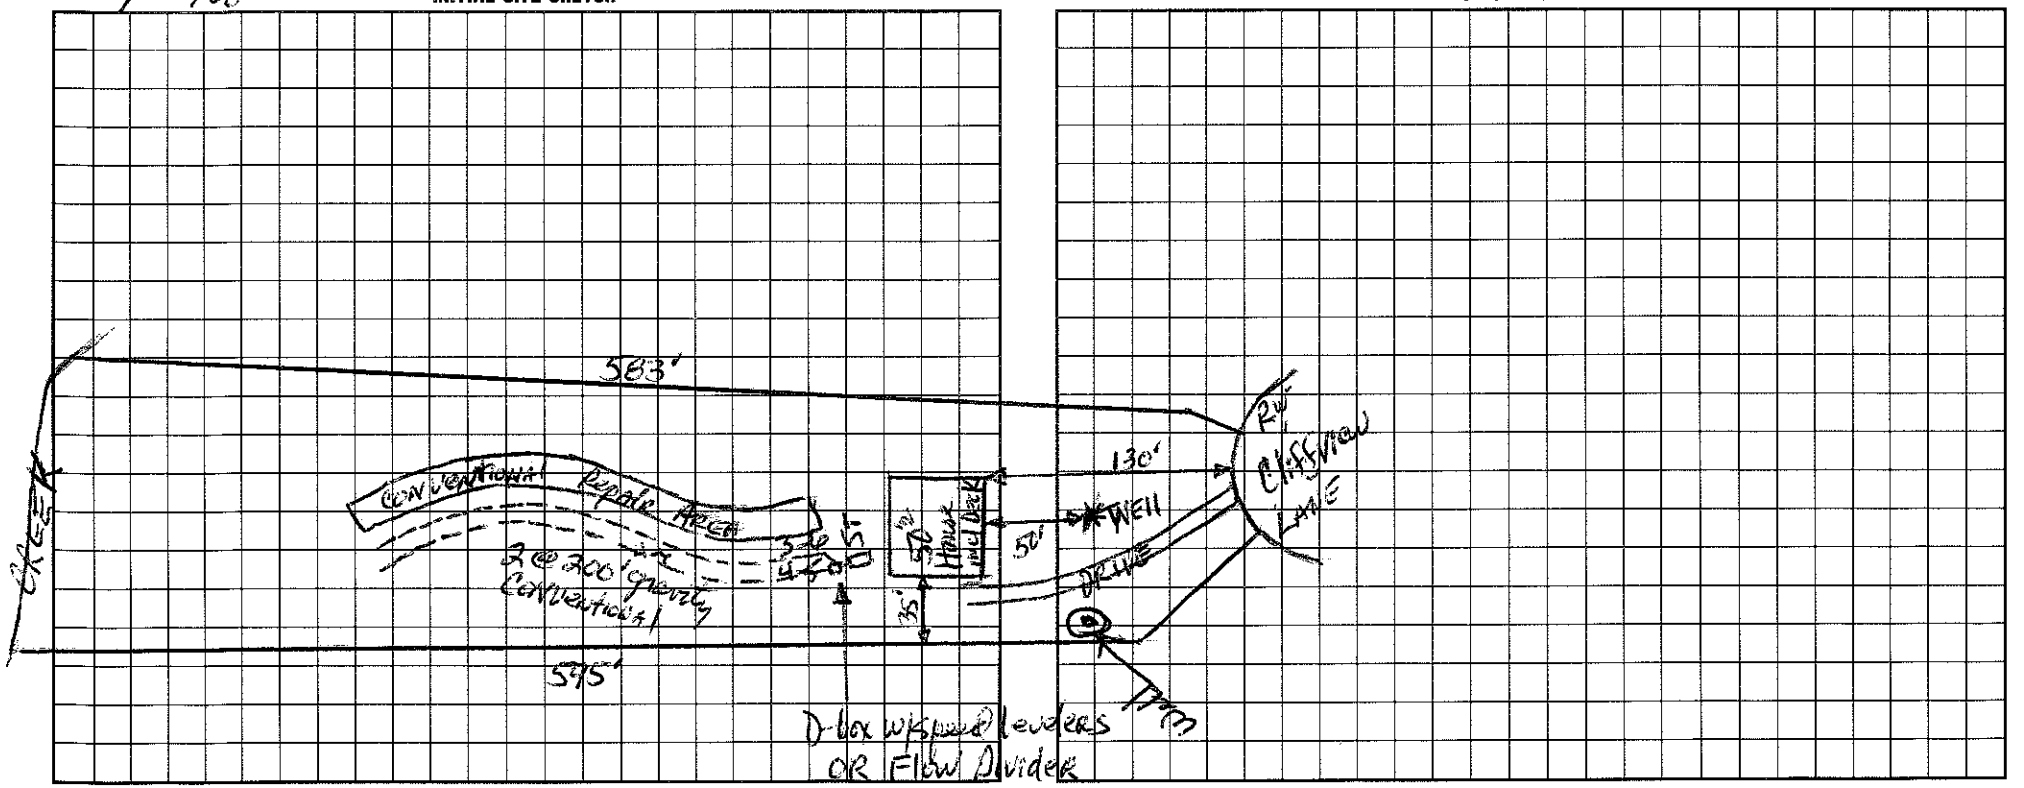

AS BUILT SKETCH

I understand that this permit can be suspended or revoked if any false information is supplied toward securing the permit/any unauthorized changes are made to the site/any unauthorized changes are made in the installation of the system. Improvement Permit is valid for 60 months from date of issuance.

Signed:

Improvement Permit by: D.K. Hymon IRS date 4-18-97

~~Construction~~ ~~Existing System Inspection~~ ~~Authorization~~ by: D.K. Hymon IRS date 4-18-97

Installed by: Rowan Septic Tank

Certificate of Completion by: Wesley Sparks RS. date 3/23/98

Operation Permit by: Wesley Sparks RS. date 3/23/98

HEALTH DEPT. COPY: WHITE INSPECTION COPY (FINAL): GREEN OWNER COPY (FINAL): YELLOW INSPECTION COPY (INITIAL): PINK OWNER COPY (INITIAL): GOLD