IREDELL COUNTY HEALTH DEPARTMENT

Coast Rd. STATESVILLE 704-878-5305 MOORESVILLE 704-664-5281

(3.00)

IMPROVEMENT PERMIT / ~~CERTIFICATE OF COMPLETION~~ / OPERATION PERMIT / EXISTING SYSTEM INSPECTION

PROPERTY DESCRIPTION NO. 24608 DATE April 18, 1997 TAX MAP NO. part of 1145

OWNER OR CONTRACTOR Ryan Financial Services PHONE: Business ~~Home~~ Watershed: ☑ Yes ☐ No

ADDRESS 149 Yacht Cove Rd. Mooresville, NC 28115 4658-02-6157

LOCATION 21 N. TL Valleyview TR Cliffview AT END

SUBDIVISION Oakbrook BLOCK / SECTION LOT 29 LOT AREA 2.26 AC SITE CLASS. AS DESIGN FLOW 360 gpd L.T.A.R. ~.35

Septic Tank: 1000 Gallons; STB 825 Date 12/19/97

Pump Tank: Gallons; PT Date

Pump Make: Model Serial No.

Nitrification Field: No Fields 1 Square Feet 1080 Linear Feet 360

No Lines ~~3 @ 90'~~ Trench Width 36" Max Trench Bottom Depth (18") Gravel Depth 12"

☑ New System ☐ Repair System Type: I, II, III, IV, V, VI

System Description: 3 @ 120' gravity conventional

Repair System Description: ~~Some~~ PANEL

Maintenance Agreement Required: ☐ Yes ☑ No

☑ House/Mod. Home No. Bedrooms 3

☐ Mobile Home No. Bathrooms 2

☐ Business No. Employees

☐ Other


☐ Slab ☑ Crawl Space ☐ Basement w/plumbing ☐ Basement wo/plumbing

Water Supply: ☑ Individual ☐ Community ☐ Public


Comments: 33 @ 90
38
5
63
1" = 100'

Comments:

INITIAL SITE SKETCH

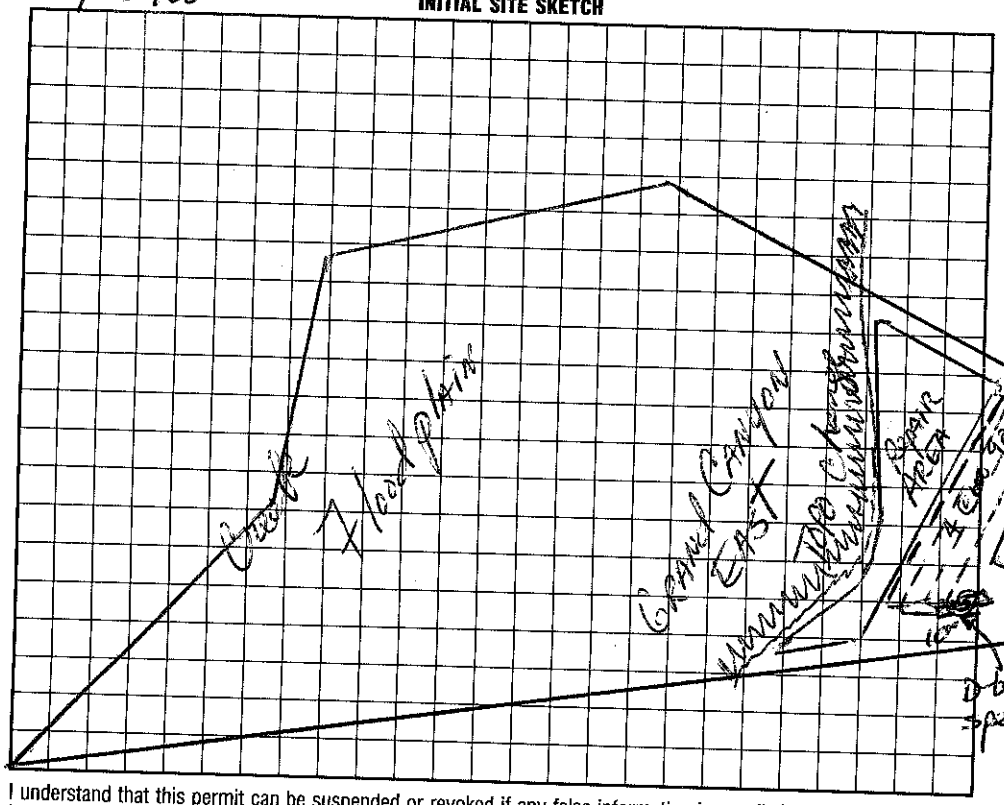

AS BUILT SKETCH

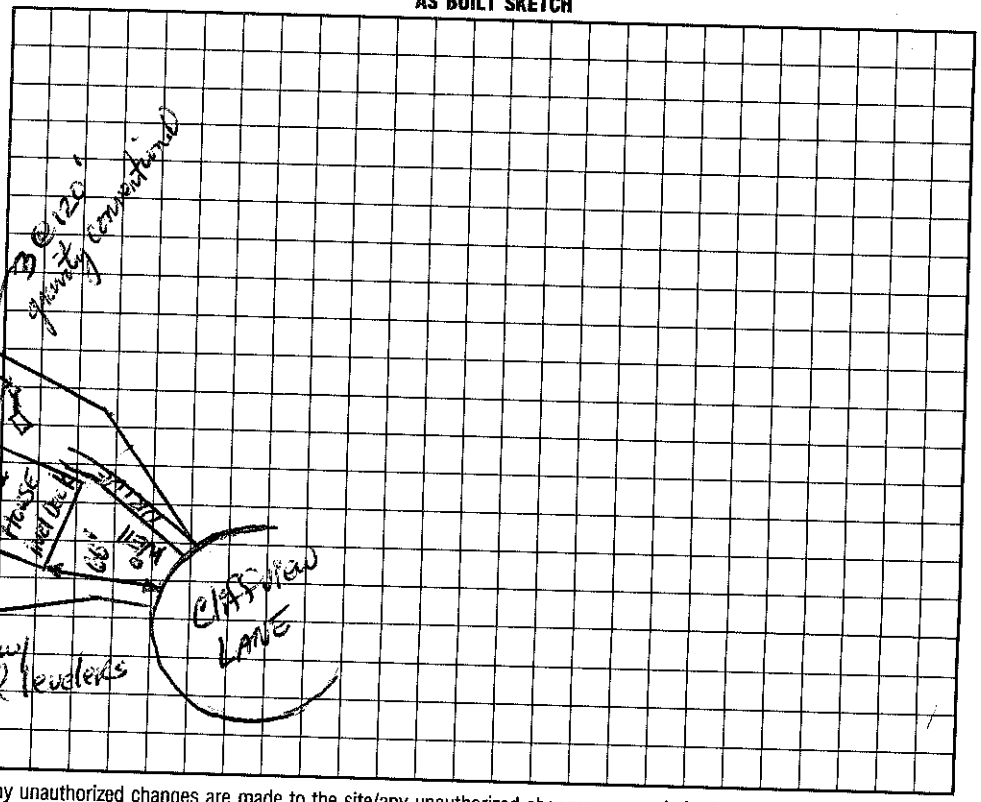

I understand that this permit can be suspended or revoked if any false information is supplied toward securing the permit/any unauthorized changes are made to the site/any unauthorized changes are made in the installation of the system. Improvement Permit is valid for 60 months from date of issuance.

Signed:

Improvement Permit by: RS date 4/18/97

Construction ~~Existing System Inspection by:~~ RS date 4/18/97

Final Inspection

Installed by: ROWAN SEPTIC

Certificate of Completion by: date

Operation Permit by: date 5/26/98

HEALTH DEPT. COPY: WHITE INSPECTION COPY (FINAL): GREEN OWNER COPY (FINAL): YELLOW INSPECTION COPY (INITIAL): PINK OWNER COPY (INITIAL): GOLD