ICHD - ENVIRONMENTAL HEALTH DIVISION

Statesville Office (704) 878-5305 | Mooresville Office (704) 660-3625

PERMIT # 2023-27917 SH.

PIN # 4658 -- 04 -- 3186 ✓

SEPTIC: IMPROVEMENT PERMIT / AUTHORIZATION TO CONSTRUCT / OPERATION PERMIT / EXISTING SYSTEM

APPLICANT/OWNER: Thomas Turner | APPLICANT ADDRESS: 339 Cornelius Rd, Mooresville

SITE ADDRESS: 339 Cornelius Rd, Mooresville 28117 ✓ | PHONE: 704-664-4056 | ALT. PHONE –

SITE DIRECTIONS: 21 N - Cornelius | SAP CONTROLLED: ☐ YES ☐ NO


SUBDIVISION: – | SECTION: – | LOT # – | LOT AREA: 1.09 acres | DESIGN FLOW: EX | L.T.A.R.: EX

Septic Tank	1000 (gal)	STB	Infiltrator	Date		☐ New System ☒ Repair ☐ Expansion	System Type: I (II) III IV V VI	☒ Residence	No. Bedrooms EX
Pump Tank	(gal)	PT		Date		System Description: –		☐ Business	No. Persons EX
Pump Make		Model		Serial #		Repair System Description:	Tank Replacement	☐ Other	No. Employees
# Nitrification Fields	EX	# Lines	EX	Linear Ft	EX	Maintenance Agreement Required:	☐ YES ☒ NO	☐ Slab	☒ Crawl Space
Trench Width	EX	Trench Bottom Depth(Low side)	EX	Gravel Depth	EX	☒ GRAVITY	☐ PRESSURE	☐ Basement w/plumbing	☐ Basement w/o plumbing

Water Supply: ☒ Private ☐ Public ☐ Community


Comments / Conditions: Pump, crush, & fill old tank. Replace distribution if necessary.

INITIAL SITE SKETCH

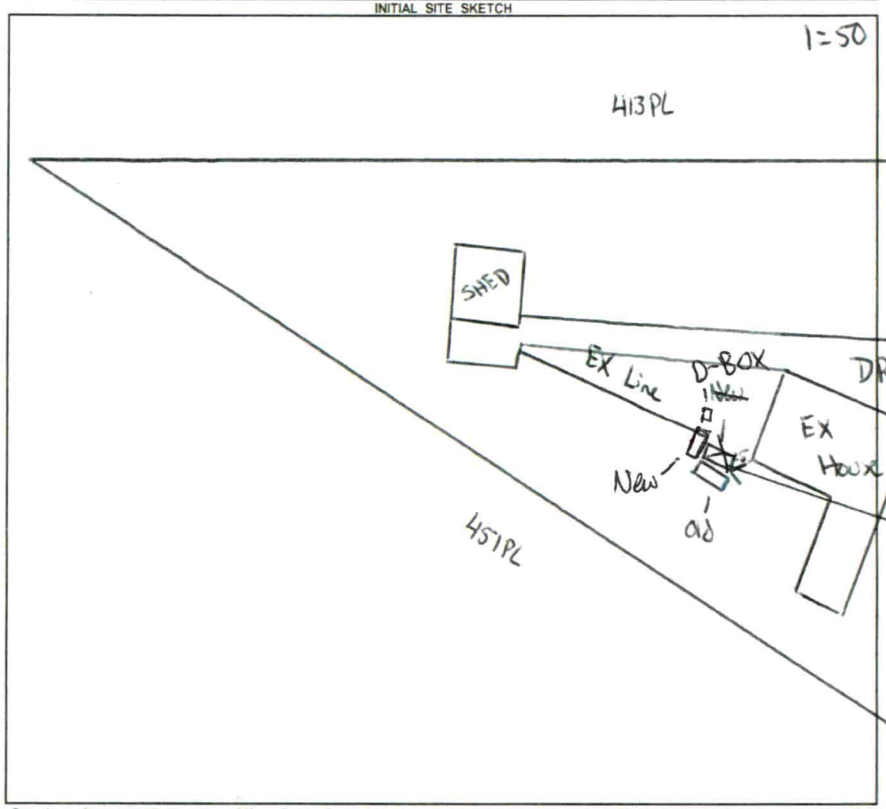

AS BUILT SKETCH

FOR SEPTIC FINAL INSPECTION CALL: 704-664-3703 between 8am-9am the day the inspection is needed. Be sure to speak with an inspector to confirm your time.

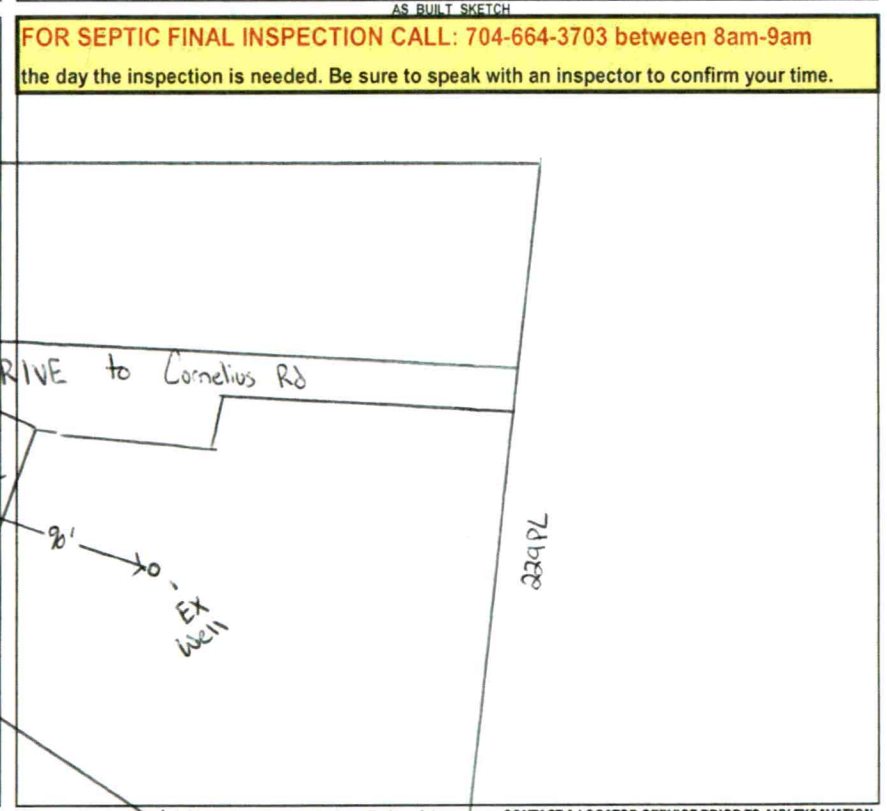

Permit can be suspended or revoked if any false information is supplied toward securing the permit / any unauthorized changes are made to the site / any unauthorized changes are made in the installation of the system. **CONTACT A LOCATOR SERVICE PRIOR TO ANY EXCAVATION**

☐ **IMPROVEMENT PERMIT** *with plat valid without expiration.* ☒ **IMPROVEMENT PERMIT** *with site plan valid for 60 mos.* ☒ **AUTHORIZATION TO CONSTRUCT** *valid for period equal to IMPROVEMENT PERMIT--not to exceed 60 mo.*

Owner / Applicant Signature: Online Signature | Date: | Installed by: Greenway Waste Solutions

IMPROVEMENT PERMIT by: Cary Whit | Date: 6/20/23 | OPERATION PERMIT by: Cary Whit | Date: 8/23/23

AUTHORIZATION TO CONSTRUCT by: Cary Whit | Date: 6/20/23 | Existing System Inspected by: | Date:

FOR SEPTIC FINAL INSPECTION: CALL 704-664-3703 between 8am-9am the day the inspection is needed.