4658049081 3-30-4:00

IREDELL COUNTY HEALTH DEPARTMENT

STATESVILLE 704-878-5305 MOORESVILLE 704-664-5281

IMPROVEMENT PERMIT / CERTIFICATE OF COMPLETION / OPERATION PERMIT / EXISTING SYSTEM INSPECTION

PROPERTY DESCRIPTION NO. 20650 DATE 5/22/95 TAX MAP NO. 1L A 46 Watershed: ☐ Yes ☒ No

OWNER OR CONTRACTOR Otis White PHONE: Business _____ Home 663-7034

ADDRESS Rt 4 Box 434 Mooresville NC. 28115

LOCATION Silver Line Rd (E) off Conshine Rd Lookout 1st house on (L)

SUBDIVISION N/A BLOCK / SECTION _____ LOT _____ LOT AREA Existing SITE CLASS. P DESIGN FLOW 360 L.T.A.R. .35

Septic Tank: 1000 Gallons; STB _____ Date _____

Pump Tank: _____ Gallons; PT _____ Date _____

Pump Make: _____ Model _____ Serial No. _____

Nitrification Field: No Fields 1 Square Feet 1200 Linear Feet ~~300~~

No Lines 3 Trench Width 36" Max Trench Bottom Depth 30" Gravel Depth N/A

☒ New System ☐ Repair System Type: I, II, III, IV, V, VI (Conventional)

System Description: ~~County~~ Lateral Trench

Repair System Description: Lateral

Maintenance Agreement Required: ☐ Yes ☒ No

☒ House/Mod. Home No. Bedrooms 3

☐ Mobile Home No. Bathrooms 2

☐ Business No. Employees _____

☐ Other _____


☐ Slab ☒ Crawl Space ☐ Basement w/plumbing ☐ Basement wo/plumbing

Water Supply:
☒ Individual
☐ Community
☐ Public
OTIS

Comments: N@ 35'x3'

Comments:

INITIAL SITE SKETCH

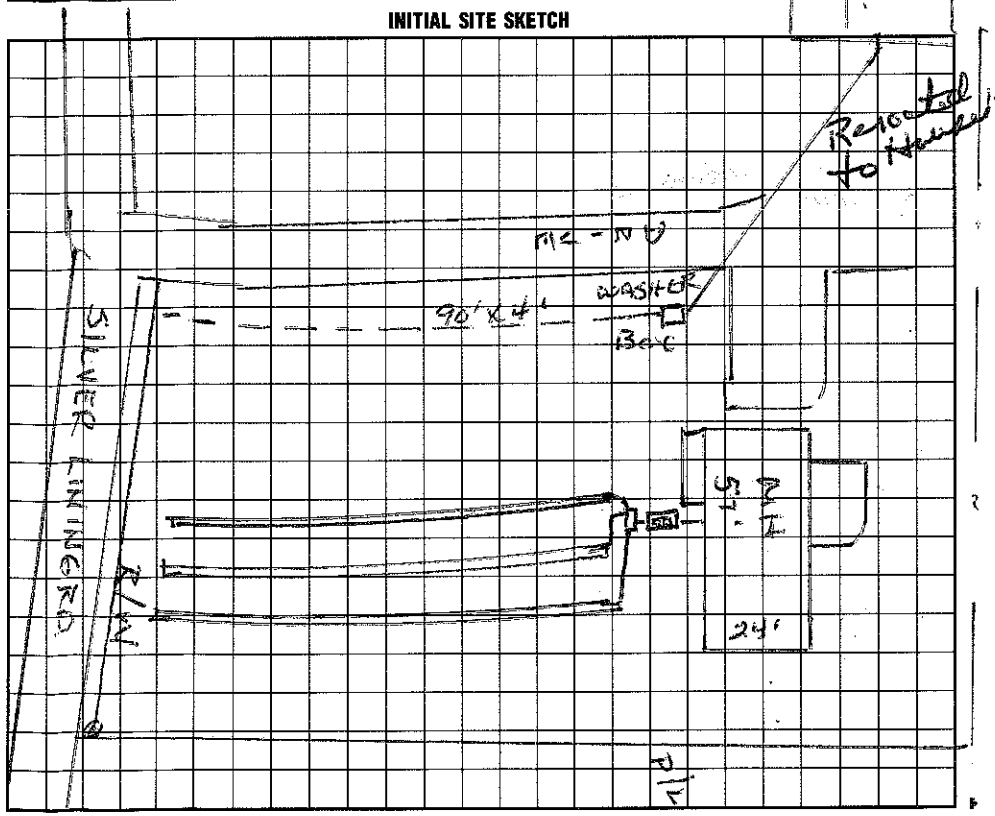

AS BUILT SKETCH

I understand that this permit can be suspended or revoked if any false information is supplied toward securing the permit/any unauthorized changes are made to the site/any unauthorized changes are made in the installation of the system. Improvement Permit is valid for 60 months from date of issuance.

Signed: X Otis White

Improvement Permit by: Wesley Sparks R.S. date 5/22/95

Existing System Inspection by: _____ date _____

Installed by: Tommy Cuthbertson

Certificate of Completion by: Wesley Sparks R.S. date 7/28/95

Operation Permit by: _____ date _____

HEALTH DEPT. COPY: WHITE INSPECTION COPY (FINAL): GREEN OWNER COPY (FINAL): YELLOW INSPECTION COPY (INITIAL): PINK OWNER COPY (INITIAL): GOLD