IREDELL COUNTY HEALTH DEPARTMENT Authorization to Construct

STATESVILLE 704-878-5305 MOORESVILLE 704-664-5281

IMPROVEMENT PERMIT / ~~CERTIFICATE OF COMPLETION~~ / OPERATION PERMIT / EXISTING SYSTEM INSPECTION

PROPERTY DESCRIPTION NO. 070133 DATE 11/17/97 TAX MAP NO. 4658049471

OWNER OR CONTRACTOR Otis White Jr. PHONE: Business _____ Home 663-7634 Watershed: ☐ Yes ☒ No

ADDRESS 121 Silverlining Rd. Mooresville, NC. 28115

LOCATION Cornelius Rd TO Silverlining Rd to 2nd Lot on (L)

SUBDIVISION _____ BLOCK / SECTION _____ LOT 1 LOT AREA ~1.75 AC SITE CLASS. PS DESIGN FLOW 360 L.T.A.R. .3

Septic Tank: 1000 Gallons; STB 1007 Date 11/11/97

Pump Tank: _____ Gallons; PT _____ Date _____

Pump Make: _____ Model _____ Serial No. _____

Nitrification Field: No Fields 1 Square Feet 1200 Linear Feet 400

No Lines 4 Trench Width 36" Max Trench Bottom Depth 36" Gravel Depth 12"

☒ New System ☐ Repair System Type: I (II) III, IV, V, VI

System Description: GRAY - CONVENTIONAL

Repair System Description: SAME

Maintenance Agreement Required: ☐ Yes ☒ No

☐ House/Mod. Home ☒ Mobile Home ☐ Business ☐ Other

No. Bedrooms 3 No. Bathrooms 2 No. Employees _____


☐ Slab ☐ Crawl Space ☐ Basement w/plumbing ☐ Basement wo/plumbing

Water Supply: ☒ Individual ☐ Community ☐ Public

Comments:

Comments:

INITIAL SITE SKETCH

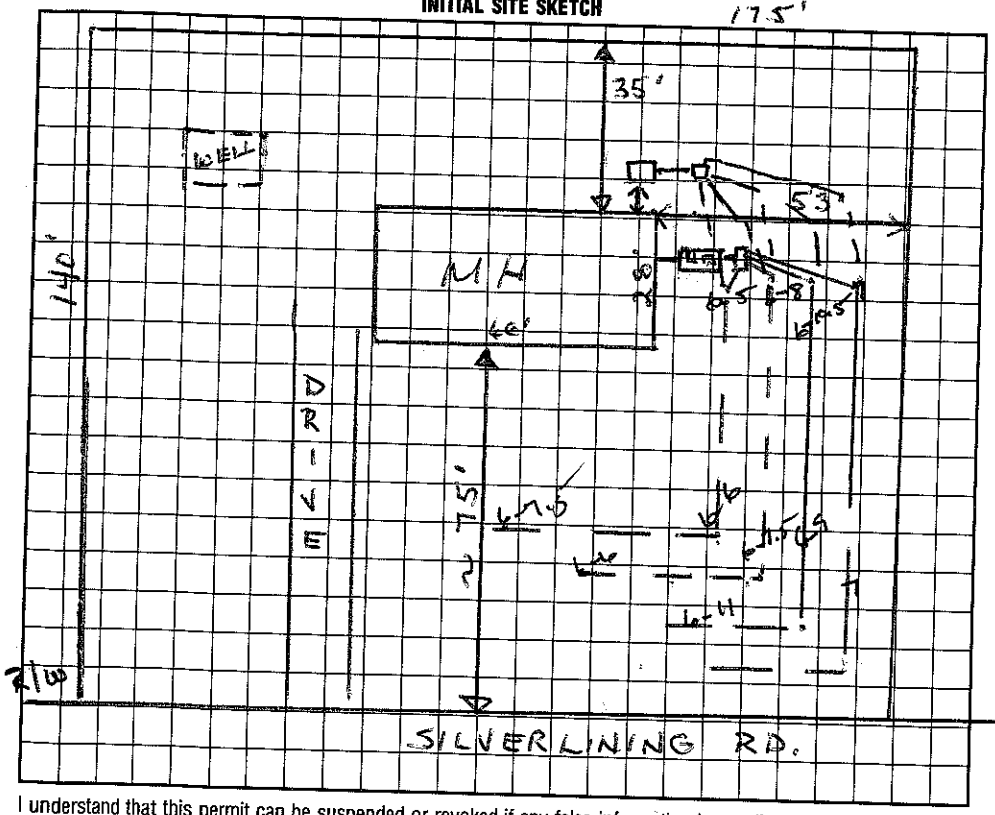

AS BUILT SKETCH

I understand that this permit can be suspended or revoked if any false information is supplied toward securing the permit/any unauthorized changes are made to the site/any unauthorized changes are made in the installation of the system. Improvement Permit is valid for 60 months from date of issuance.

Signed: * Otis S. White Jr.

Improvement Permit by: Wesley Sparks R.S. date 11/17/97

Existing System Inspection by: Wesley Sparks R.S. date 11/17/97

Installed by: Andy Daniels

Certificate of Completion by: Wesley Sparks R.S. date 12/18/97

Operation Permit by: Wesley Sparks R.S. date 12/18/97

Accepted

HEALTH DEPT. COPY: WHITE INSPECTION COPY (FINAL): GREEN OWNER COPY (FINAL): YELLOW INSPECTION COPY (INITIAL): PINK OWNER COPY (INITIAL): GOLD