4:22 pm

IREDELL COUNTY HEALTH DEPARTMENT

STATESVILLE 704-878-5305 MOORESVILLE 704-664-5281

IMPROVEMENT PERMIT / AUTHORIZATION TO CONSTRUCT / OPERATION PERMIT / EXISTING SYSTEM INSPECTION

PERMIT# 120362 PIN# 4658-05-2952 DATE 1/13/05

OWNER OR CONTRACTOR Cornelius Est LLC PHONE: Business _____ Home _____

ADDRESS 130 Lazy La, Mooresville NC 28117

LOCATION HWY 21 N, TL Cornelius, TR Olympia on Rt just Past Ariel

SUBDIVISION Cornelius BLOCK / SECTION _____ LOT 13 LOT AREA 2.606 Ac SITE CLASS PS DESIGN FLOW 480 L.T.A.R. 0.3

Septic Tank: 1000 Gallons; STB 821 Date 4/25/05
Pump Tank: 1000 Gallons; PT _____ Date 4/21/05
Pump Make: ZOELLER Model N137C Serial No. 12/3/04
Nitrification Field: No Fields 1 Square Feet 1200 Linear Feet 400
No Lines 6 @ 67' Trench Width 36" Max Trench Bottom Depth 36" Gravel Depth —

☒ New System ☐ Repair System Type: I, II, (III), IV, V, VI
System Description: PM 25% Reduction
Repair System Description: Pump Innovative
Maintenance Agreement Required: ☐ Yes ☒ No

☒ House/Mod. Home No. Bedrooms 4
☐ Mobile Home No. Bathrooms ____
☐ Business No. Employees ____
☐ Other ____

☐ Slab ☒ Crawl Space ☐ Basement w/plumbing ☐ Basement wo/plumbing


Water Supply: ☒ Individual ☐ Public ☐ Community

Comments:/Conditions:

1" = 100'

Comments:/Conditions:

INITIAL SITE SKETCH

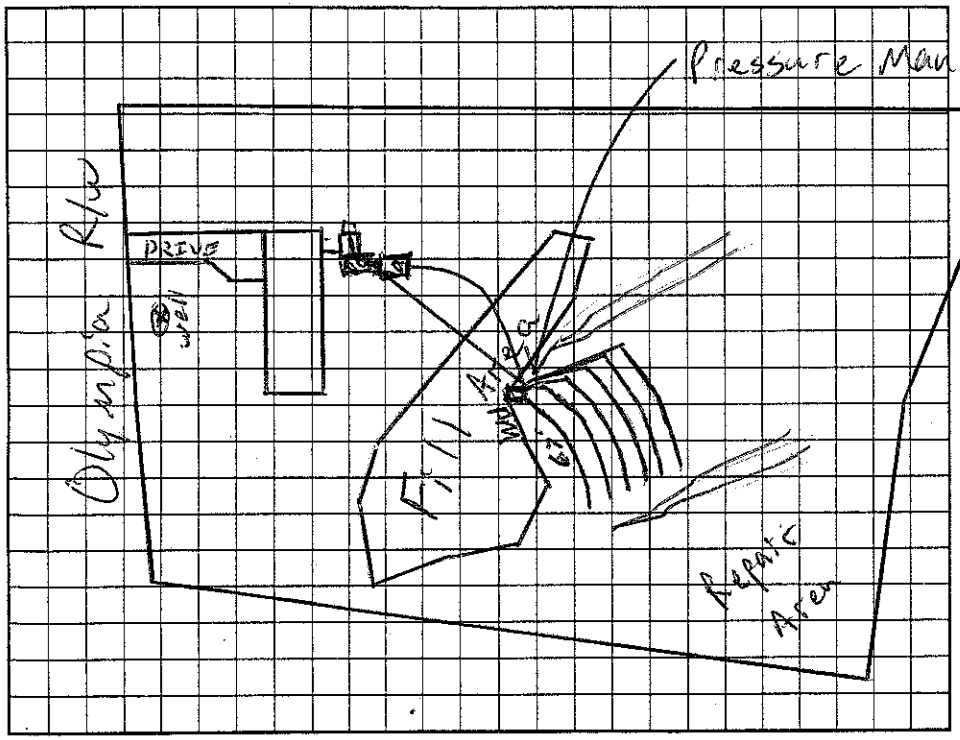

AS BUILT SKETCH

Permit can be suspended or revoked if any false information is supplied toward securing the permit/any unauthorized changes are made to the site/any unauthorized changes are made in the installation of the system. Improvement Permit with plat valid without expiration. Improvement Permit with site plan valid for sixty months. Authorization to Construct is valid for a period equal to that of Improvement Permit – not to exceed sixty months.

Signed: _____ date 1-18-05 Installed by: J+M Enterprises

Improvement Permit by: _____ RS date 1/13/05 Operation Permit by: _____ RS date 6/14/05

Authorization to Construct by: _____ RS date 1/13/05 Existing System Inspection by: _____ date _____

HEALTH DEPT. COPY: WHITE OWNER COPY (FINAL): YELLOW OWNER COPY (INITIAL): PINK