IREDELL COUNTY HEALTH DEPARTMENT

STATESVILLE 704-878-5305 MOORESVILLE 704-664-5281

IMPROVEMENT PERMIT / AUTHORIZATION TO CONSTRUCT / OPERATION PERMIT / EXISTING SYSTEM INSPECTION

PERMIT# 116243/124664 PIN# ~~4698-95-6947.03~~ 4685-05-3205 DATE 11/2/03

OWNER OR CONTRACTOR Ready Redfear PHONE: Business _____ Home 704-892-1666

ADDRESS PO Box 554 Cornelius NC 28031

LOCATION 21 N, TL Cornelius, TR Olympia, TR Areil on Rt.

SUBDIVISION Cornelius Est. BLOCK / SECTION _____ LOT 3 LOT AREA 1.185Ac. SITE CLASS. PS DESIGN FLOW 480 L.T.A.R. 0.35

Septic Tank: 1000 Gallons; STB 312 Date 11/29/04

Pump Tank: _____ Gallons; PT _____ Date _____

Pump Make: _____ Model _____ Serial No. _____

Nitrification Field: No. Fields 1 Square Feet 1365 Linear Feet 455

No Lines 7@65' Trench Width 36" Max Trench Bottom Depth 36" Gravel Depth 12"

☒ New System ☐ Repair System Type: I, ☒ II, III, IV, V, VI

System Description: Gravity Conventional

Repair System Description: 25% Reduction

Maintenance Agreement Required: ☐ Yes ☒ No

☒ House/Mod. Home ☐ Mobile Home ☐ Business ☐ Other

No. Bedrooms 4 No. Bathrooms 2.5 No. Employees ____


☐ Slab ☒ Crawl Space ☐ Basement w/plumbing ☐ Basement wo/plumbing

Water Supply: ☒ Individual ☐ Public ☐ Community

Comments:/Conditions:

1"=60'

INITIAL SITE SKETCH

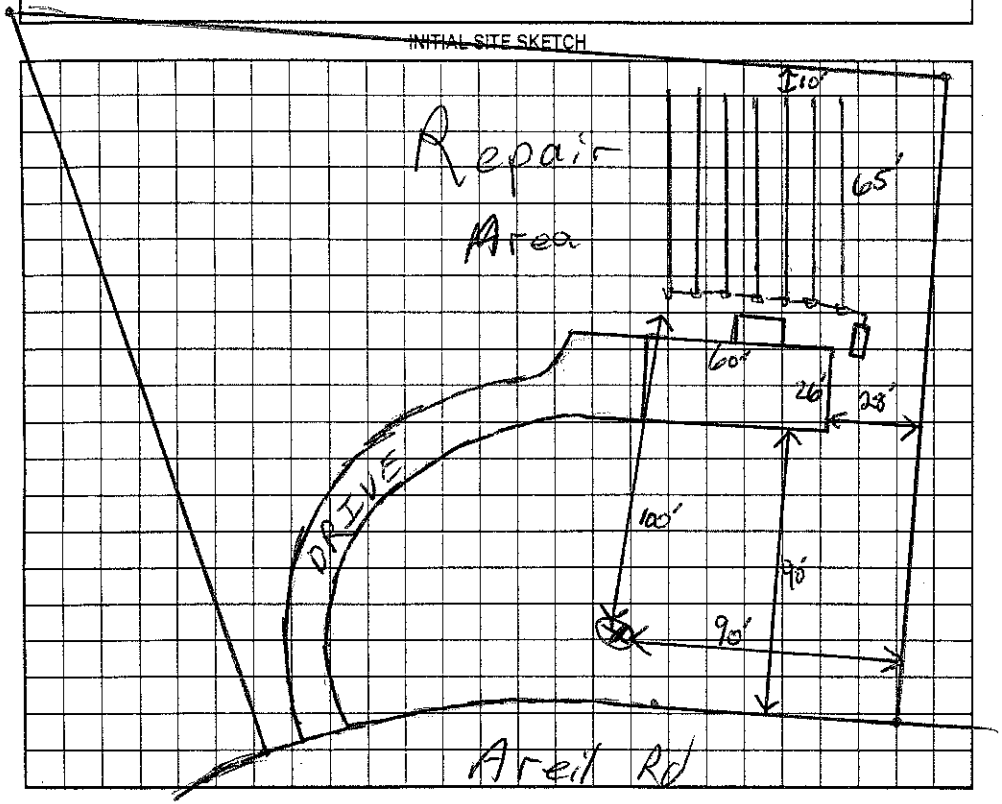

Comments:/Conditions:

AS BUILT SKETCH

Installed As Drawn

Permit can be suspended or revoked if any false information is supplied toward securing the permit/any unauthorized changes are made to the site/any unauthorized changes are made in the installation of the system. Improvement Permit with plat valid without expiration. Improvement Permit with site plan valid for sixty months. Authorization to Construct is valid for a period equal to that of Improvement Permit – not to exceed sixty months.

Signed: _____ date _____ Installed by: A-Cornelius Grading

Improvement Permit by: RS date 11/02/03 Operation Permit by: RS date 11/6/05

Authorization to Construct by: RS date 11/02/03 Existing System Inspection by: _____ date _____

HEALTH DEPT. COPY: WHITE OWNER COPY (FINAL): YELLOW OWNER COPY (INITIAL): PINK