IREDELL COUNTY HEALTH DEPARTMENT

STATESVILLE 704-878-5305 130.00 Paid MOORESVILLE 704-664-5281 3:30

IMPROVEMENT PERMIT / AUTHORIZATION TO CONSTRUCT / OPERATION PERMIT / EXISTING SYSTEM INSPECTIO

PERMIT# 118453 PIN# 4658055128 4777 mike DATE 2/27/04

OWNER OR CONTRACTOR New Watt Homes PHONE: Business 996-4542 Home 663-2552

ADDRESS 720 Shearers Rd Mooresville, NC

LOCATION US 21 North TR Cornelius TR Olympia TR 1st street (Ariel Dr) lot on right

SUBDIVISION Cornelius Estates BLOCK / SECTION ____ LOT 64 LOT AREA 1.684 Acre SITE CLASS. PS DESIGN FLOW 360gpd L.T.A.R. .37

Septic Tank: 1000 Gallons; STB 1012 Date 10-11-05

Pump Tank: ____ Gallons; PT ____ Date ____

Pump Make: ____ Model ____ Serial No. ____

Nitrification Field: No Fields 4 Square Feet 900' Linear Feet 300'

No Lines 4 @ 75 Trench Width 3' Max Trench Bottom Depth 36 Gravel Depth N/A

[X] New System [ ] Repair System Type: I, II, III, IV, V, VI

System Description: Gravity 25% Reduction

Repair System Description: Panel Block

Maintenance Agreement Required: [ ] Yes [X] No

[X] House/Mod. Home No. Bedrooms 3

[ ] Mobile Home No. Bathrooms 2.5

[ ] Business No. Employees ____

[ ] Other ____


[ ] Slab [X] Crawl Space [ ] Basement w/plumbing [ ] Basement wo/plumbing

Water Supply: [X] Individual [ ] Public [ ] Community

Comments:/Conditions: Keep Septic System at least 10' From PL & 50-100' From Well

Comments:/Conditions: Reviewed Building Plans; essentially in Compliance with Improvement Permit. Well variance attached Installed Quick 4 for Drainfield

Scale 1:50 INITIAL SITE SKETCH

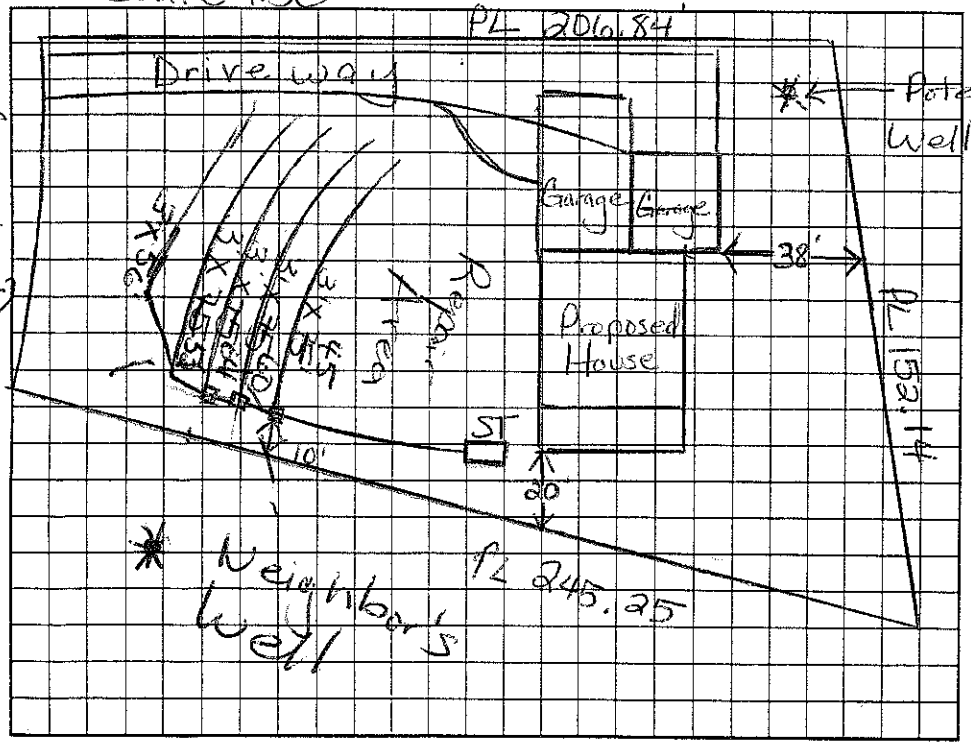

AS BUILT SKETCH

A Neighbors Well not where Septic permit showed it, therefore could not install permit as shown & keep 50' From well. (Neighbor's permit attached)

Permit can be suspended or revoked if any false information is supplied toward securing the permit/any unauthorized changes are made to the site/any unauthorized changes are made in the installation of the system. Improvement Permit with plat valid without expiration. Improvement Permit with site plan valid for sixty months. Authorization to Construct is valid for a period equal to that of Improvement Permit – not to exceed sixty months.

Signed: Michael Watt date 3/3/04

Improvement Permit by: Maria H. Dotson RS date 2/27/04

Authorization to Construct by: Maria H. Dotson RS date 6/1/04

Installed by: Piedmont Backhoe Steve Jordan

Operation Permit by: Maria H. Dotson RS date 11/31/06

Existing System Inspection by: ____ date ____

HEALTH DEPT. COPY: WHITE OWNER COPY (FINAL): YELLOW OWNER COPY (INITIAL): PINK