IREDELL COUNTY HEALTH DEPARTMENT

STATESVILLE 704-878-5305 MOORESVILLE 704-664-5281

IMPROVEMENT PERMIT / AUTHORIZATION TO CONSTRUCT / OPERATION PERMIT / EXISTING SYSTEM INSPECTION

PERMIT# 27560 PIN# 4658 05 5425 DATE 6/3/05

OWNER OR CONTRACTOR Nahum Alvarez PHONE: Business _____ Home 704 202-8552

ADDRESS 114 Skylark Way Mooresville NC 28115

LOCATION HWY 21 N, TL Cornelius Rd, TR Olympia, TR Arty l, on Lt

SUBDIVISION Cornelius Est BLOCK / SECTION _____ LOT 9 LOT AREA 1.276AC SITE CLASS. PS DESIGN FLOW 480 L.T.A.R. 0.25

Septic Tank: 1000 Gallons; STB 794 Date 12/15/05
Pump Tank: _____ Gallons; PT _____ Date _____
Pump Make: _____ Model _____ Serial No. _____
Nitrification Field: No Fields 1 Square Feet 1440 Linear Feet 480
No Lines 4 Trench Width 36" Max Trench Bottom Depth 18"

☑ New System ☐ Repair System Type: I (II) III, IV, V, VI
System Description: Gravity 25% Reduct / LPP
Repair System Description: _____
Maintenance Agreement Required: ☐ Yes ☒ No

☒ House/Mod. Home No. Bedrooms 4
☐ Mobile Home No. Bathrooms ___
☐ Business No. Employees ___
☐ Other _____


Gravel Depth — ☐ Slab ☒ Crawl Space ☐ Basement w/plumbing ☐ Basement wo/plumbing

Water Supply: ☒ Individual ☐ Public ☐ Community


Comments:/Conditions:

Comments:/Conditions:

INITIAL SITE SKETCH

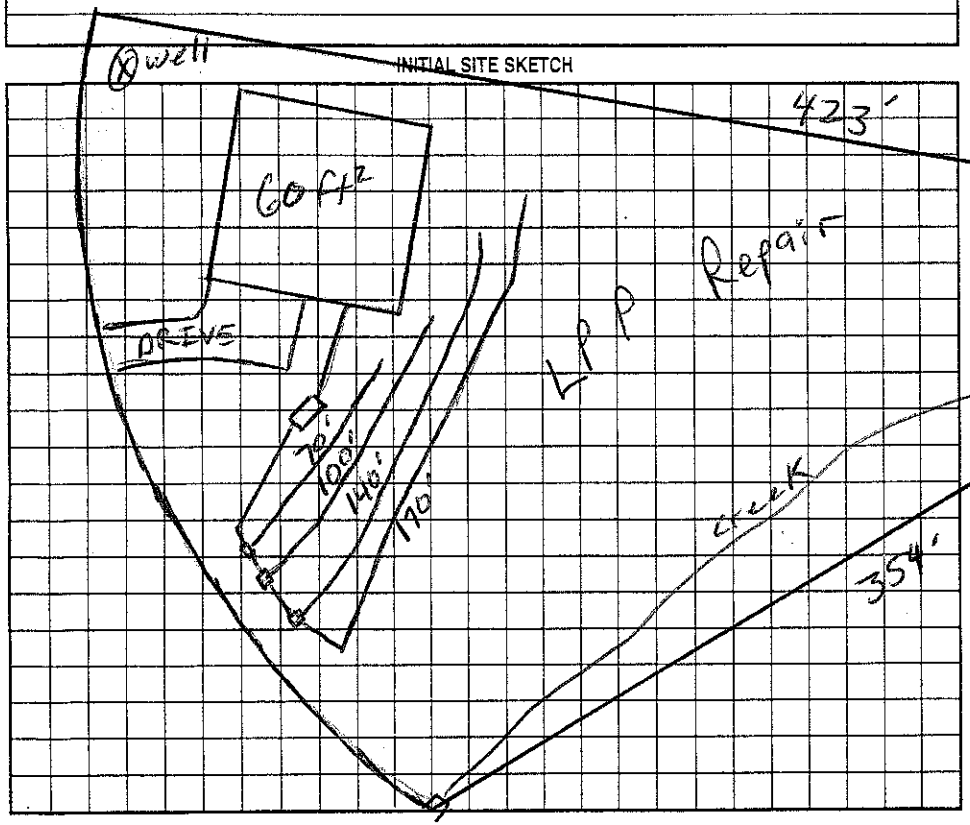

AS BUILT SKETCH

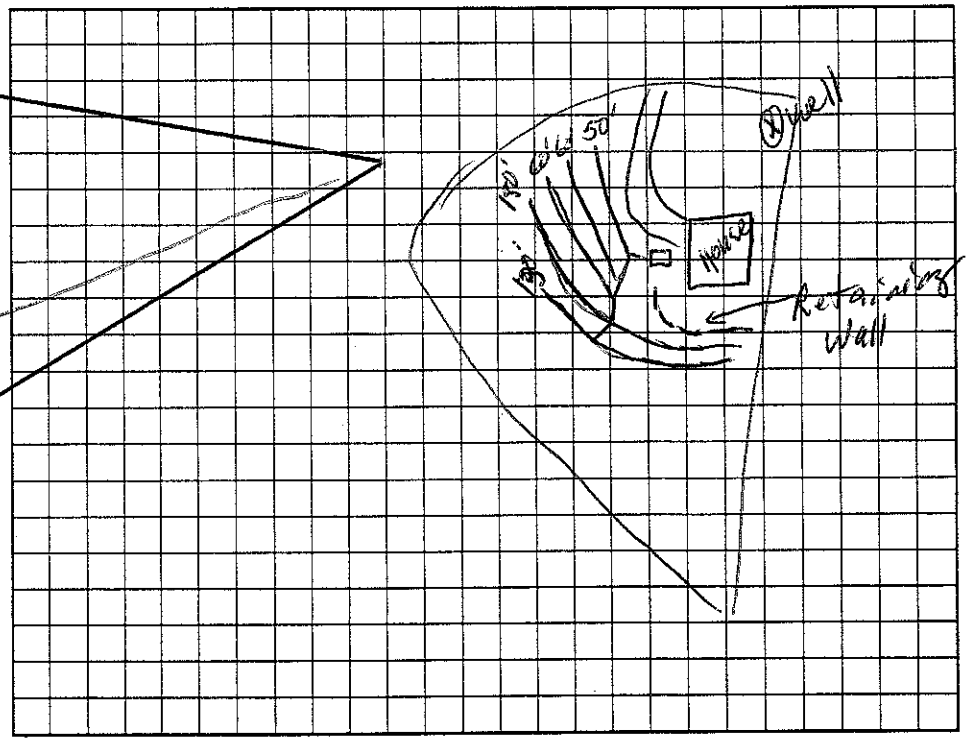

Permit can be suspended or revoked if any false information is supplied toward securing the permit/any unauthorized changes are made to the site/any unauthorized changes are made in the installation of the system. Improvement Permit with plat valid without expiration. Improvement Permit with site plan valid for sixty months. Authorization to Construct is valid for a period equal to that of Improvement Permit – not to exceed sixty months.

Signed: [signature] date 6/3/05 Installed by: Paul Howard

Improvement Permit by: [signature] RS date 6/3/05 Operation Permit by: [signature] RS date 3/5/06

Authorization to Construct by: [signature] RS date 6/3/05 Existing System Inspection by: _____ date _____

HEALTH DEPT. COPY: WHITE OWNER COPY (FINAL): YELLOW OWNER COPY (INITIAL): PINK