IREDELL COUNTY HEALTH DEPARTMENT

STATESVILLE [illegible]-5305 MOORESVILLE 704-664-5281

IMPROVEMENT PERMIT / AUTHORIZATION TO CONSTRUCT / OPERATION PERMIT / EXISTING SYSTEM INSPECTION

PERMIT# 117072 PIN# ~~4648-95-6447.5~~ 4658057251 DATE 2/6/04

OWNER OR CONTRACTOR Spear Builders Inc PHONE: Business 704-202-4964 Home

ADDRESS 192 Wildwood Cove Dr. Mooresville NC 28117

LOCATION 2 L N. TL Cornelius, TR Olympia, TR Artel, on Rt.

SUBDIVISION Cornelius Est BLOCK / SECTION LOT 5 LOT AREA 1.243 AC SITE CLASS. PS DESIGN FLOW 360 L.T.A.R. 0.5

Septic Tank: 1000 Gallons: STB 825 Date 11/20/03

Pump Tank: Gallons: PT Date

Pump Make: Model Serial No.

Nitrification Field: No Fields 1 Square Feet 900 Linear Feet 300

No Lines 4@75 Trench Width 36" Max Trench Bottom Depth 36" Gravel Depth —

☒ New System ☐ Repair System Type: I, II, III, IV, V, VI

System Description: Gravity 25% Red.

Repair System Description: Pump 25% Red

Maintenance Agreement Required: ☐ Yes ☒ No

☒ House/Mod. Home No. Bedrooms 3

☐ Mobile Home No. Bathrooms 2

☐ Business No. Employees

☐ Other

☒ Slab ☐ Crawl Space ☐ Basement w/plumbing ☐ Basement wo/plumbing

Water Supply: ☒ Individual ☐ Public ☐ Community

Comments:/Conditions:

Comments:/Conditions:

The proposed / ~~existing~~ Pergola over deck addition does not appear to impact the existing septic system.


**NOTE:

Judy Melville R.S.

Date: 1-20-10

ICHD-Environmental Health Division

INITIAL SITE SKETCH

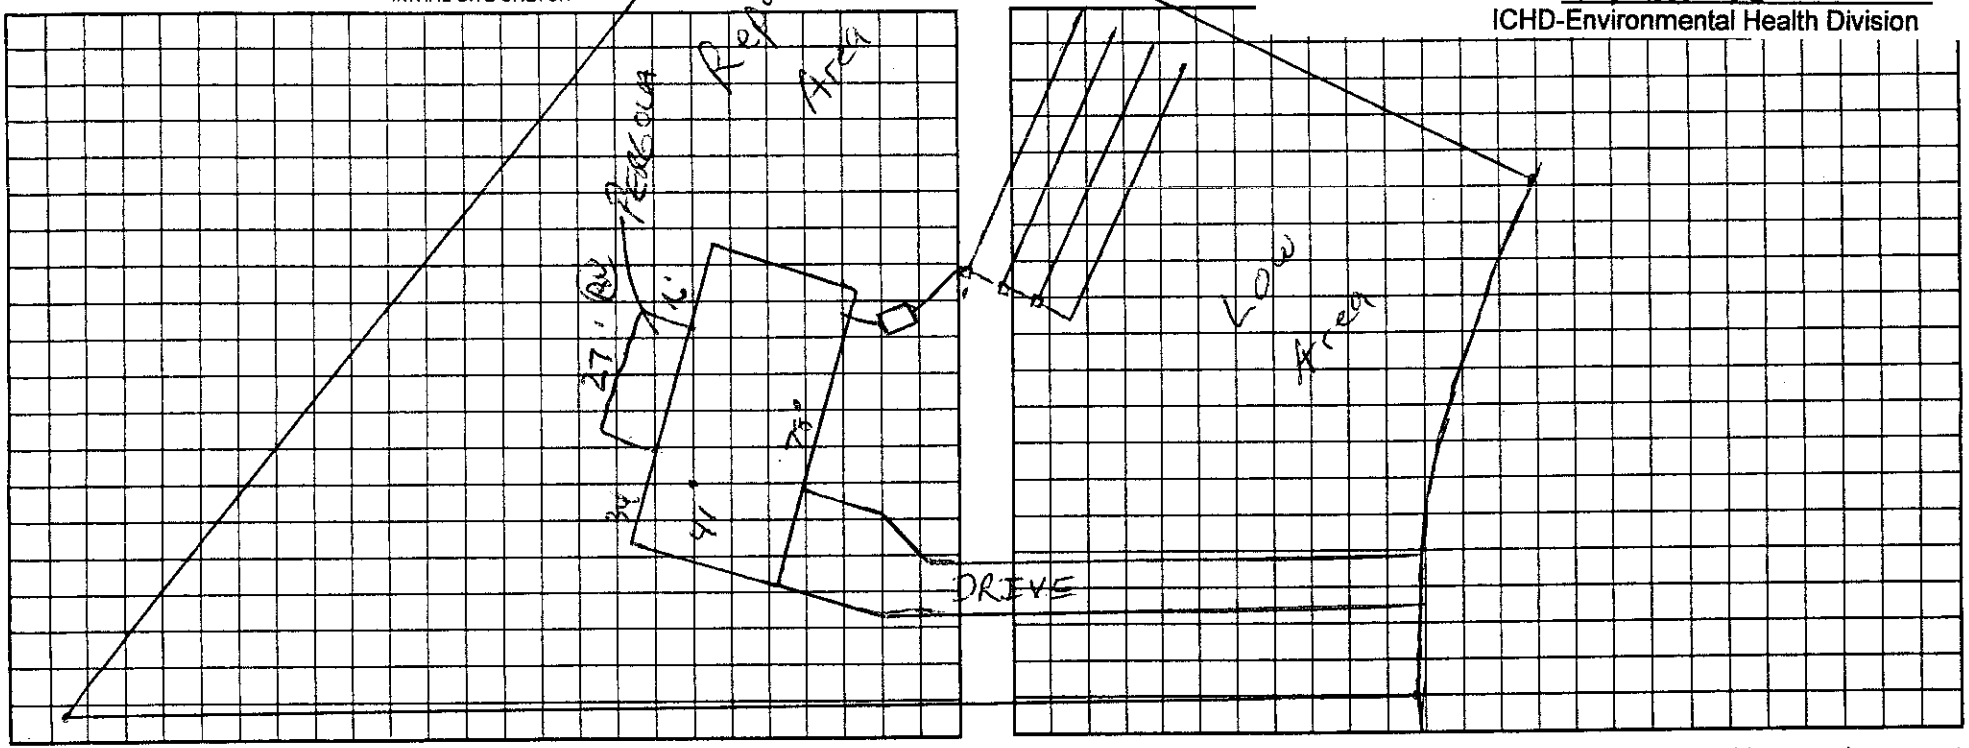

Permit can be suspended or revoked if any false information is supplied toward securing the permit/any unauthorized changes are made to the site/any unauthorized changes are made in the installation of the system. Improvement Permit with plat valid without expiration. Improvement Permit with site plan valid for sixty months. Authorization to Construct is valid for a period equal to that of Improvement Permit – not to exceed sixty months.

Signed: date 2/26/04

Improvement Permit by: RS date 2/6/04

Authorization to Construct by: RS date 2/6/04

Installed by: Rowan Septic

Operation Permit by: RS date 2-6-04

Existing System Inspection by: date

HEALTH DEPT. COPY: WHITE OWNER COPY (FINAL): YELLOW OWNER COPY (INITIAL): PINK

IREDELL COUNTY HEALTH DEPARTMENT

STATESVILLE 704-878-5305 MOORESVILLE 704-664-5281

11:30

IMPROVEMENT PERMIT / AUTHORIZATION TO CONSTRUCT / OPERATION PERMIT / EXISTING SYSTEM INSPECTION

PERMIT # 159005 PIN # 4658-19-1003 DATE 11-25-09

OWNER or APPLICANT GRAYSON + EDITH STAMEY/SHANE PAGE TELEPHONE: Business 704-281-5727 Home: ADAM GETCHELL

OWNER or APPLICANT ADDRESS PO BOX 843 HUNTERSVILLE NC

LOCATION / DIRECTIONS 150, 21N, TL CORNELIUS, TR OLYMPIA, TL SPARTA END OF CUL-DE-SAC

SUBDIVISION CORNELIUS ESTATES BLOCK / SECTION LOT # 27 LOT AREA 12.18 AC DESIGN FLOW 360 GPD L.T.A.R. .3

Septic Tank 1000 GAL Gallons: STB 901 Date 11-18-09

Pump Tank Gallons: P T Date

Pump Make Model Serial #

Nitrification Field No Fields 1 No Lines 3 Linear Feet 300'

Trench Width 36" Max. Trench Bottom Depth 36" Gravel Depth —

☒ New System ☐ Repair ☐ Expansion System Type I (II) III IV V VI

System Description: GRAVITY 25% REDUCTION

Repair System Description: SAME

Maintenance Agreement Required ☐ YES ☒ NO

☒ GRAVITY ☐ PRESSURE


☒ Residence No. Bedrooms 3 ☐ Business No. Persons ☐ Other No. Employees ☐ Slab ☒ Crawl Space ☐ Basement w/plumbing ☐ Basement w/o plumbing

Water Supply: ☒ Private ☐ Public ☐ Community


Comments / Conditions

Comments / Conditions 1) INSTALL 3@100' LINES ON CONTOUR 2) IF CHAMBER ARE USED, END CAPS CAN REPLACE DROP BOXES Installed EZ Flow as drawn.

INITIAL SITE SKETCH

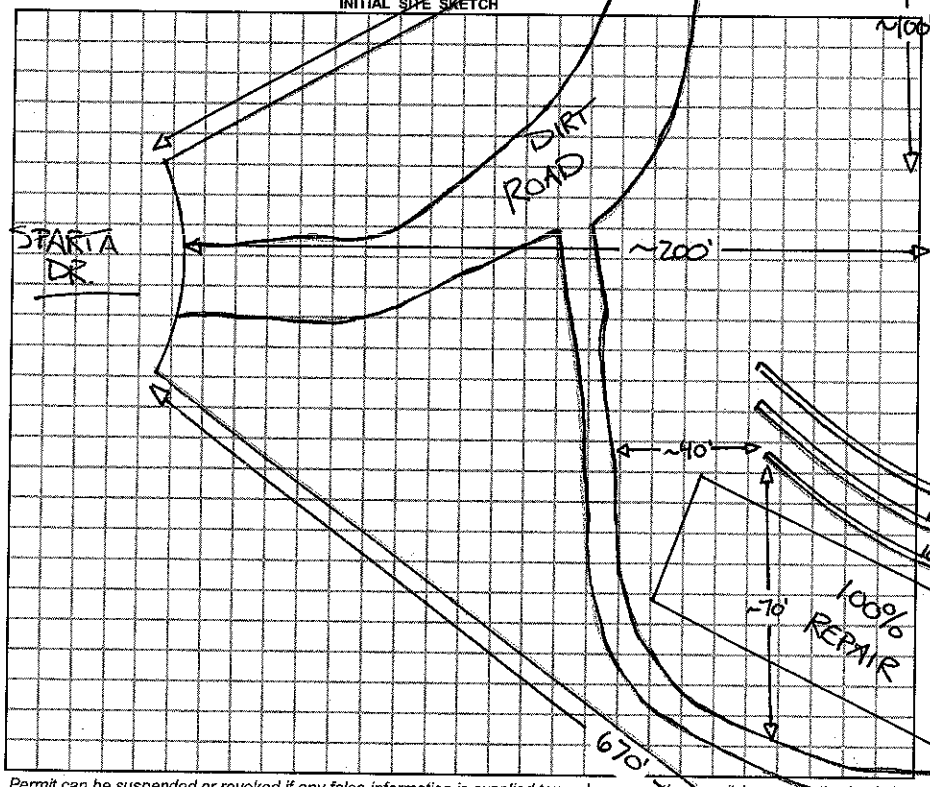

AS BUILT SKETCH

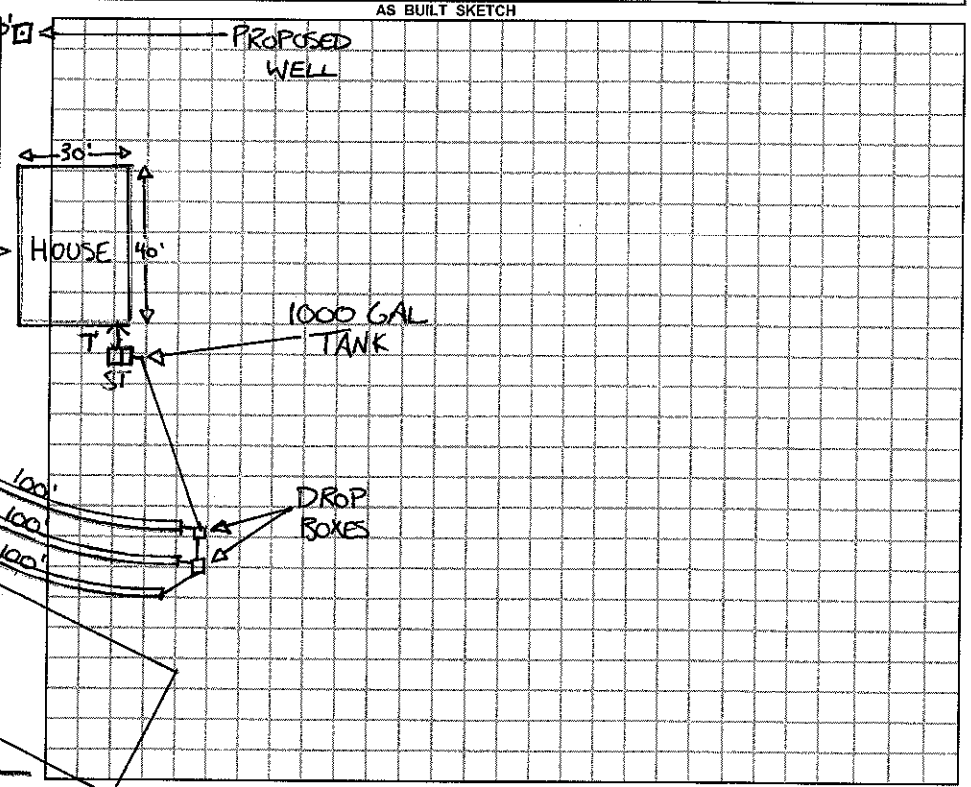

Permit can be suspended or revoked if any false information is supplied toward securing the permit / any unauthorized changes are made to the site / any unauthorized changes are made in the installation of the system.

☐ *IMPROVEMENT PERMIT w / plat valid without expiration.* ☐ *IMPROVEMENT PERMIT w / site plan valid for 60 mos.* ☒ *AUTHORIZATION TO CONSTRUCT valid for period equal to IMPROVEMENT PERMIT-not to exceed 60 mo.*

Owner / Applicant Signature: Date 11-30-09

Improvement Permit by: REHS Date 11-25-09

Authorzation to Construct by: REHS Date 11-25-09

YOU SHOULD CONTACT A LOCATOR SERVICE PRIOR TO ANY EXCAVATION.

Installed by: Dennis Willis Septic

Operation Permit by: REHS Date: 4/2/2010

Existing System Inspected by: Date:

WHITE COPY Environmental Health YELLOW COPY (Final) Owner / Applicant PINK COPY (Initial) Owner / Applicant