IREDELL COUNTY HEALTH DEPARTMENT

STATESVILLE 704-878-5305 MOORESVILLE 704-664-5281

$130

IMPROVEMENT PERMIT / AUTHORIZATION TO CONSTRUCT / OPERATION PERMIT / EXISTING SYSTEM INSPECTION

PERMIT# 17166 PIN# ~~4648-95-6847.000~~ 4658-05-9522 DATE 11/26/03

OWNER OR CONTRACTOR Spear Builders PHONE: Business 704 202-4964 Home

ADDRESS 192 Wildwood Ln Mooresville NC 28117

LOCATION 21 N, TL Cornelius, TR Olympia, TR Ariel, on Rt at Cul de sac

SUBDIVISION Cornelius Est. BLOCK / SECTION LOT 50 LOT AREA 0.643Ac SITE CLASS. PS DESIGN FLOW 480 L.T.A.R. 0.5

Septic Tank: 1000 Gallons: STB 925 Date 12/2/03
Pump Tank: Gallons: PT Date
Pump Make: Model Serial No.
Nitrification Field: No Fields 1 Square Feet 1200 Linear Feet 400'
No Lines 5 or 6 Trench Width 36" Max Trench Bottom Depth 36" Gravel Depth

☒ New System ☐ Repair System Type: I, II, III, IV, V, VI
System Description: Gravity 25% Reduction
Repair System Description: Pump Panel Block
Maintenance Agreement Required: ☐ Yes ☒ No

☒ House/Mod. Home ☐ Mobile Home ☐ Business ☐ Other
No. Bedrooms 4 No. Bathrooms 2½ No. Employees

Water Supply: ☒ Individual ☐ Public ☐ Community


☒ Slab ☒ Crawl Space ☐ Basement w/plumbing ☐ Basement wo/plumbing

Comments:/Conditions:


1"=50'

Comments:/Conditions:

INITIAL SITE SKETCH

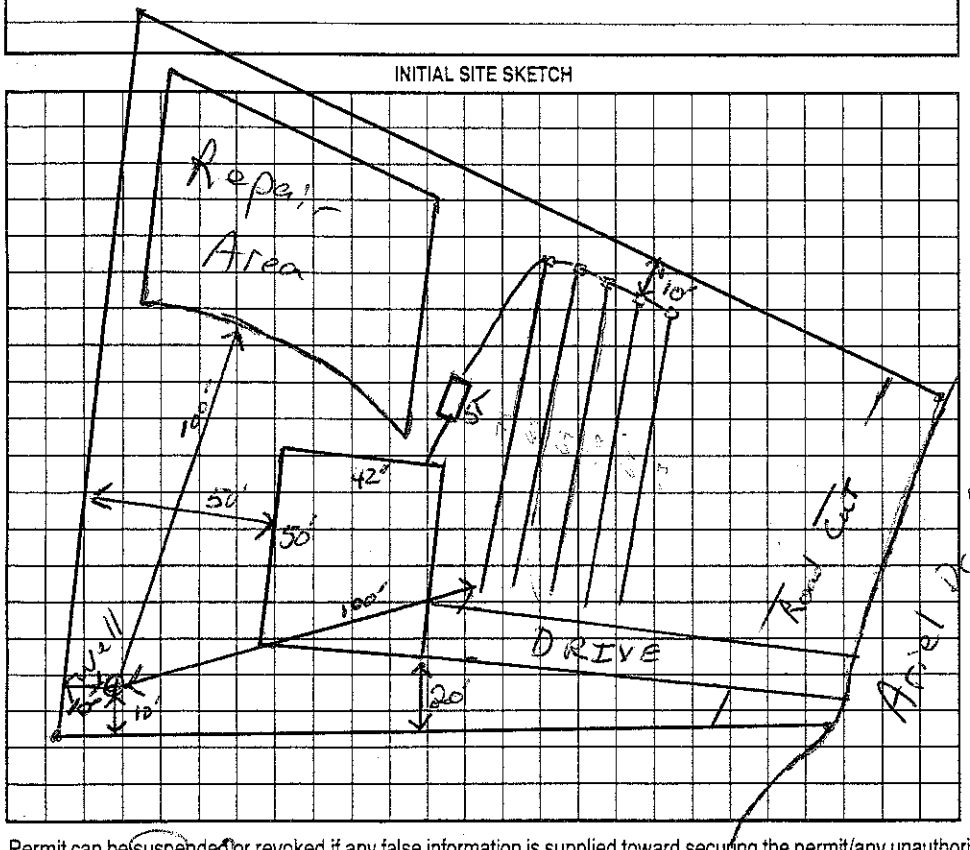

AS BUILT SKETCH

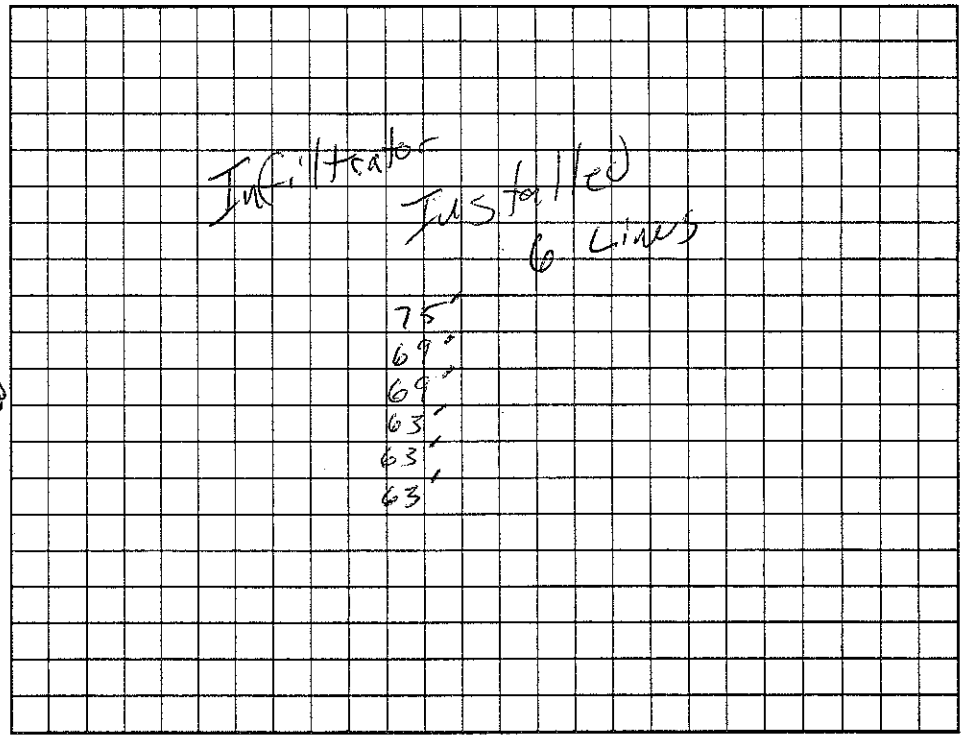

Permit can be suspended or revoked if any false information is supplied toward securing the permit/any unauthorized changes are made to the site/any unauthorized changes are made in the installation of the system. Improvement Permit with plat valid without expiration. Improvement Permit with site plan valid for sixty months. Authorization to Construct is valid for a period equal to that of Improvement Permit – not to exceed sixty months.

Signed: date

Improvement Permit by: RS date 11/26/03

Authorization to Construct by: RS date 11/26/03

Installed by: Rowan Sept.c

Operation Permit by: RS date 3/10/04

Existing System Inspection by: date

HEALTH DEPT. COPY: WHITE OWNER COPY (FINAL): YELLOW OWNER COPY (INITIAL): PINK