IREDELL COUNTY HEALTH DEPARTMENT

STATESVILLE 704-878-5305 MOORESVILLE 704-664-5281

IMPROVEMENT PERMIT / AUTHORIZATION TO CONSTRUCT / OPERATION PERMIT / EXISTING SYSTEM INSPECTION

130.00 Eq. 1 130

PERMIT# 117073 PIN# ~~4648-95-6447.51~~ 4658-05-9636 DATE 12/16/03

OWNER OR CONTRACTOR Spear Const. Inc. PHONE: Business 704-636-7954 Home

ADDRESS 607 Anderson Ave. Salisbury NC 28144

LOCATION 21 N, TL Cornelius Rd, TR Olympia, TR Ariel on Rt at End

SUBDIVISION Cornelius Est BLOCK / SECTION LOT 51 LOT AREA 0.643 AC SITE CLASS PS DESIGN FLOW 360 L.T.A.R. 0.3

Septic Tank: 1000 Gallons; STB 975 Date 2/12/04
Pump Tank: Gallons; PT Date
Pump Make: Model Serial No.
Nitrification Field: No Fields 1 Square Feet 900 Linear Feet 300'
No Lines 5 @ 60' Trench Width 36" Max Trench Bottom Depth 36" Gravel Depth —

☒ New System ☐ Repair System Type: I, II, III, IV, V, VI
System Description: Gravity 25% Reduct.
Repair System Description: Same
Maintenance Agreement Required: ☐ Yes ☒ No


☒ House/Mod. Home No. Bedrooms 3
☐ Mobile Home No. Bathrooms 2
☐ Business No. Employees
☐ Other
☐ Slab ☐ Crawl Space ☐ Basement w/plumbing ☐ Basement wo/plumbing

Water Supply: ☒ Individual ☐ Public ☐ Community

Comments:/Conditions:

1" = 40'


INITIAL SITE SKETCH

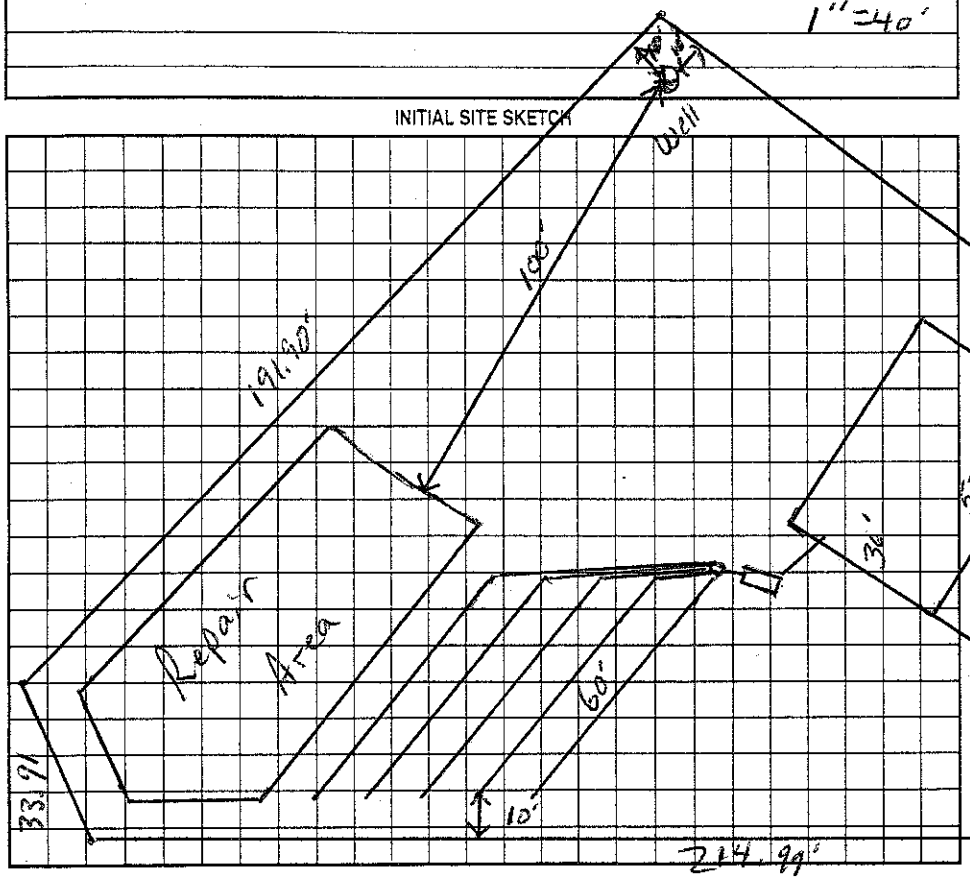

Comments:/Conditions:

Infiltrators Installed @ 75'
Slope Nearly Flat - Lines are not going Out of Contour

AS BUILT SKETCH

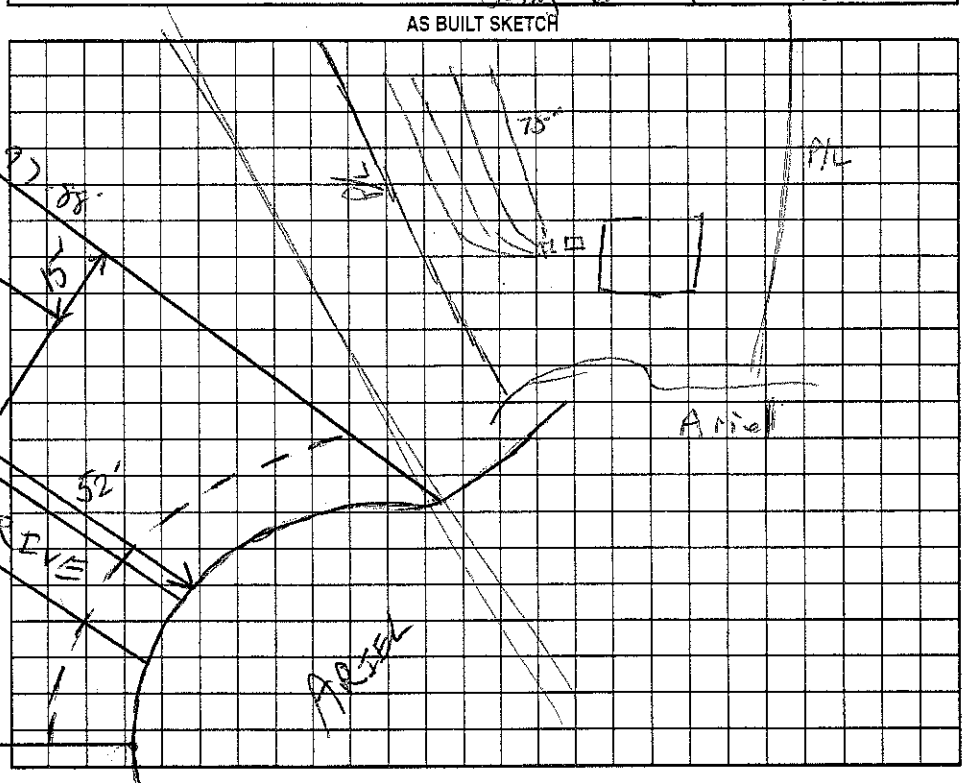

Permit can be suspended or revoked if any false information is supplied toward securing the permit/any unauthorized changes are made to the site/any unauthorized changes are made in the installation of the system. Improvement Permit with plat valid without expiration. Improvement Permit with site plan valid for sixty months. Authorization to Construct is valid for a period equal to that of Improvement Permit – not to exceed sixty months.

Signed: Stanley Shaya date 1-30-04 Installed by: Rowan Septic

Improvement Permit by: RS date 12/16/03 Operation Permit by: RS date 4/29/04

Authorization to Construct by: RS date 12/16/03 Existing System Inspection by: date

HEALTH DEPT. COPY: WHITE OWNER COPY (FINAL): YELLOW OWNER COPY (INITIAL): PINK