IREDELL COUNTY HEALTH DEPARTMENT

STATESVILLE 704-878-5305 — MOORESVILLE 704-664-5281

Paid 2100

IMPROVEMENT PERMIT / AUTHORIZATION TO CONSTRUCT / OPERATION PERMIT / EXISTING SYSTEM INSPECTION

PERMIT# 11763 PIN# 4658-06-0338 DATE 1/14/04

OWNER OR CONTRACTOR Spear Const. PHONE: Business 704 636 7954 Home

ADDRESS 607 Anderson Ave Salisbury NC 28144

LOCATION 21 N, TL Cornelius, TR Olympia, TL Alyah, 2nd on RT

SUBDIVISION Cornelius Est. BLOCK / SECTION LOT 53 LOT AREA 0.505 AC SITE CLASS PS DESIGN FLOW 360 L.T.A.R. .03

Septic Tank: 1000 Gallons; STB 825 Date 6-7-04

Pump Tank: Gallons; PT Date

Pump Make: Model Serial No.

Nitrification Field: No Fields 1 Square Feet 900 Linear Feet 300

No Lines 3@100' Trench Width 36" Max Trench Bottom Depth 36" Gravel Depth —

☒ New System ☐ Repair System Type: I, II, III, IV, V, VI

System Description: Gravity 25% Reduct

Repair System Description: Panel Block

Maintenance Agreement Required: ☐ Yes ☒ No

☒ House/Mod. Home ☐ Mobile Home ☐ Business ☐ Other

No. Bedrooms 3 No. Bathrooms 2 No. Employees


☐ Slab ☒ Crawl Space ☐ Basement w/plumbing ☐ Basement wo/plumbing

Water Supply: ☒ Individual ☐ Public ☐ Community


Comments:/Conditions: Do not cut For House site
Drive can be moved to opposite side
1" = 40'

Comments:/Conditions: 12 Blue polylok
14
14
8

INITIAL SITE SKETCH

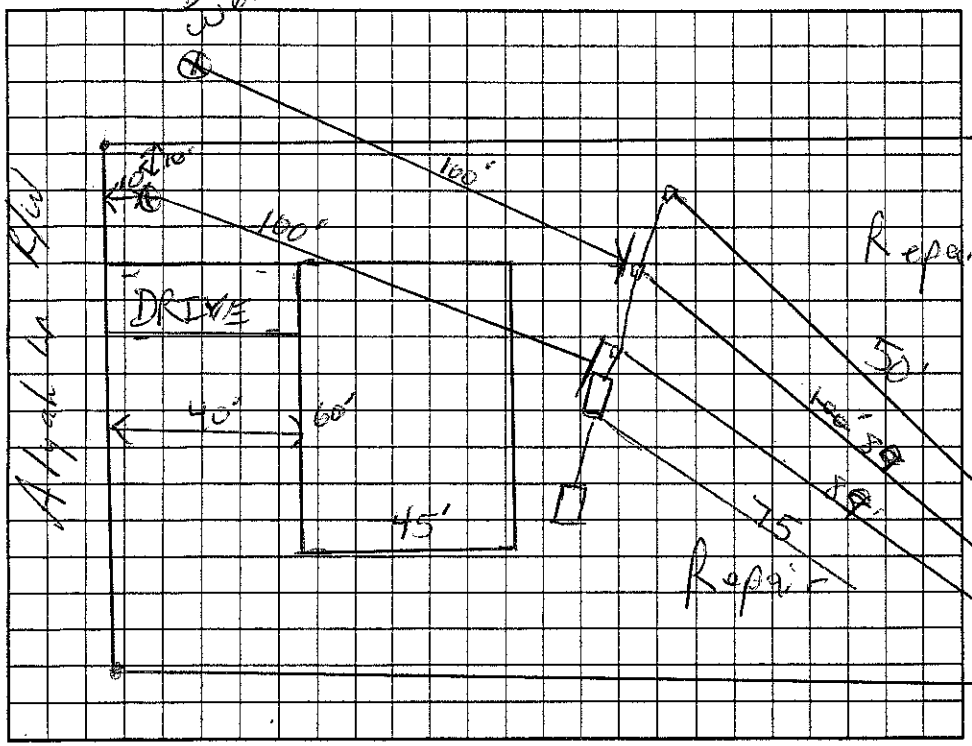

AS BUILT SKETCH

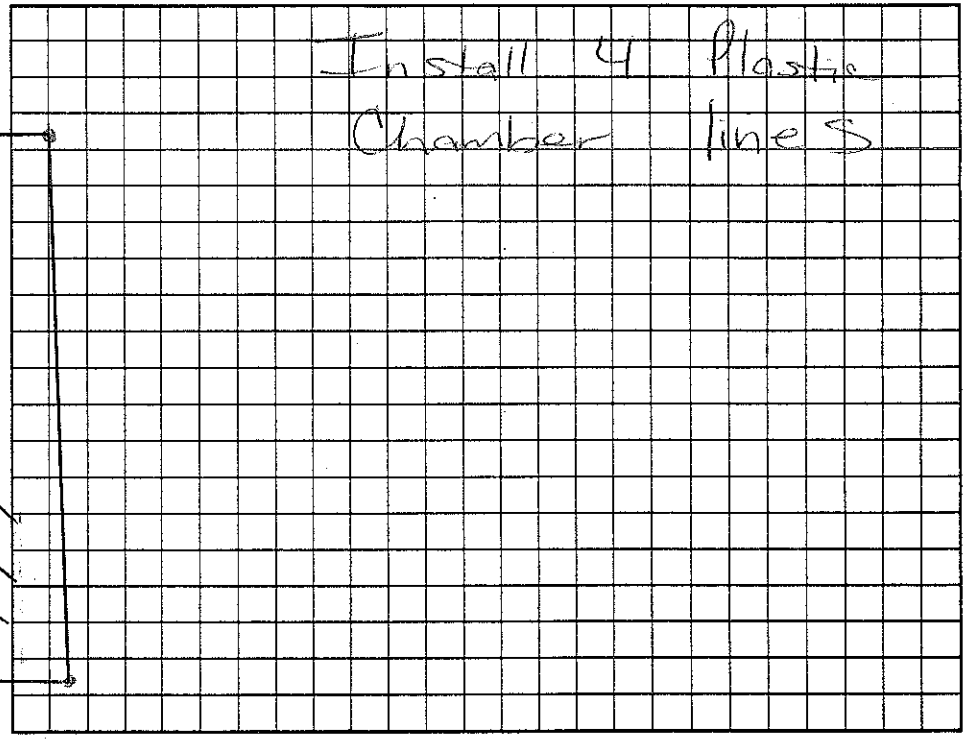

Permit can be suspended or revoked if any false information is supplied toward securing the permit/any unauthorized changes are made to the site/any unauthorized changes are made in the installation of the system. Improvement Permit with plat valid without expiration. Improvement Permit with site plan valid for sixty months. Authorization to Construct is valid for a period equal to that of Improvement Permit – not to exceed sixty months.

Signed: Stanley Sharp date 1-30-04 Installed by: Rowan Septic

Improvement Permit by: RS date 1/14/04 Operation Permit by: Maria H Robson RS date 8/20/04

Authorization to Construct by: RS date 1/14/04 Existing System Inspection by: date

HEALTH DEPT. COPY: WHITE OWNER COPY (FINAL): YELLOW OWNER COPY (INITIAL): PINK