IREDELL COUNTY HEALTH DEPARTMENT

STATESVILLE 704-878-5305 130.00 Paid MOORESVILLE 704-664-5281

IMPROVEMENT PERMIT / AUTHORIZATION TO CONSTRUCT / OPERATION PERMIT / EXISTING SYSTEM INSPECTION

PERMIT# 117640 PIN# 4658-06-1310 DATE 1/14/04

OWNER OR CONTRACTOR Spear Const. PHONE: Business 704-636-7954 Home

ADDRESS 607 Anderson Ave. Salisbury NC 28144

LOCATION 21 N, TL Cornelius, TR Olympia, on corner w/ Alyah Ln.

SUBDIVISION Cornelius Est. BLOCK / SECTION LOT 52 LOT AREA 0.624 AC SITE CLASS. PS DESIGN FLOW 360 L.T.A.R. 0.35

Septic Tank: 1000 Gallons; STB 825 Date 6/1/04

Pump Tank: Gallons; PT Date

Pump Make: Model Serial No.

Nitrification Field: No Fields 1 Square Feet 780 Linear Feet 260

No Lines 4@65' Trench Width 36" Max Trench Bottom Depth 36" Gravel Depth —

☒ New System ☐ Repair System Type: I, II, (III), IV, V, VI

System Description: Gravity 25% Reduction

Repair System Description: Panel Block

Maintenance Agreement Required: ☐ Yes ☒ No

☒ House/Mod. Home ☐ Mobile Home ☐ Business ☐ Other

No. Bedrooms 3 No. Bathrooms No. Employees


☐ Slab ☒ Crawl Space ☐ Basement w/plumbing ☐ Basement wo/plumbing

Water Supply: ☐ Individual ☐ Public ☐ Community

Comments:/Conditions:

1" = 40'

INITIAL SITE SKETCH

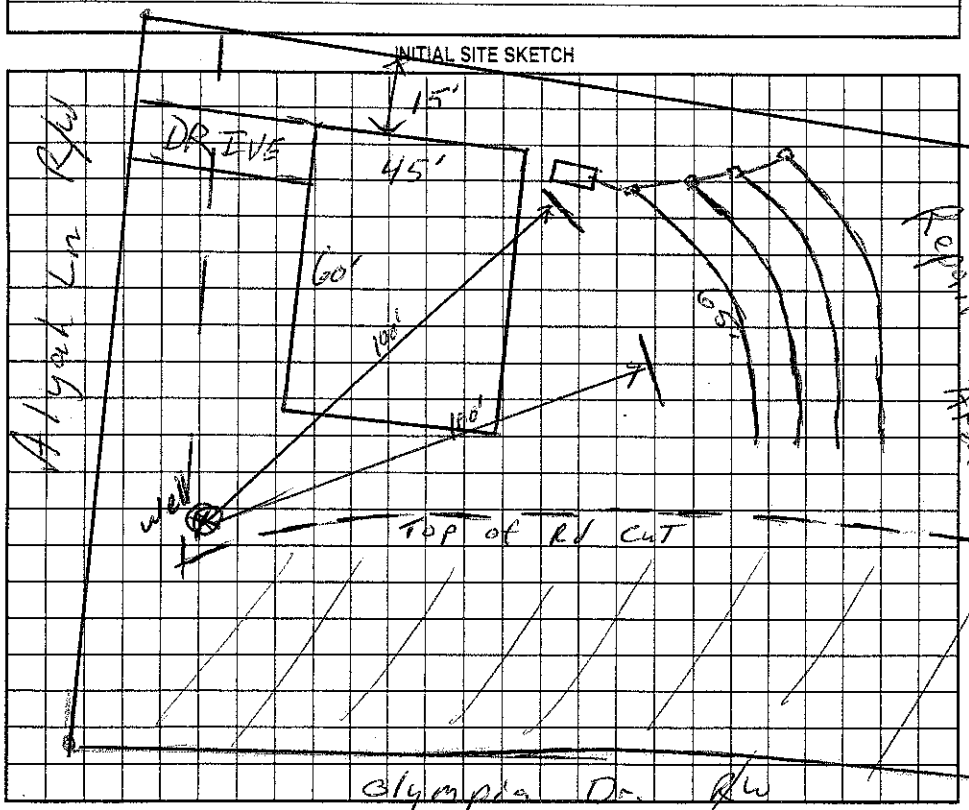

Comments:/Conditions:

AS BUILT SKETCH

Infiltrators Installed

Permit can be suspended or revoked if any false information is supplied toward securing the permit/any unauthorized changes are made to the site/any unauthorized changes are made in the installation of the system. Improvement Permit with plat valid without expiration. Improvement Permit with site plan valid for sixty months. Authorization to Construct is valid for a period equal to that of Improvement Permit – not to exceed sixty months.

Signed: Stanley Shaye date 1-30-04 Installed by: Rowan Septic

Improvement Permit by: RS date 1/14/04 Operation Permit by: RS date 8/16/04

Authorization to Construct by: RS date 4/12/04 Existing System Inspection by: date

HEALTH DEPT. COPY: WHITE OWNER COPY (FINAL): YELLOW OWNER COPY (INITIAL): PINK