IREDELL COUNTY HEALTH DEPARTMENT

STATESVILLE 704-878-5305 MOORESVILLE 704-664-5281

IMPROVEMENT PERMIT / AUTHORIZATION TO CONSTRUCT / OPERATION PERMIT / EXISTING SYSTEM INSPECTION

PERMIT # 1566623 PIN # 4658063210 DATE 5/28/09

OWNER or APPLICANT Dana Beckham PHONE: Business 704.677.4355 Home: 704.662.8056

OWNER or APPLICANT ADDRESS 156 Olympia Dr. Mooresville

LOCATION / DIRECTIONS 21 N, TL Cornelius Rd., TR Olympia, on Rt.

SUBDIVISION Cornelius Estates BLOCK / SECTION — LOT # 83 LOT AREA 1 acre DESIGN FLOW 360 gpd L.T.A.R. 0.35

Septic Tank 1000 Gallons: STB 310 Date 11/9/04

Pump Tank — Gallons: PT — Date —

Pump Make — Model — Serial # —

Nitrification Field No Fields 1 No Lines 4 Linear Feet 260

Trench Width 36" Max. Trench Bottom Depth 36" Gravel Depth —

☐ New System ☐ Repair ☐ Expansion System Type I (II) III IV V VI

System Description: existing gravity 25%

Repair System Description: LP PPBPS

Maintenance Agreement Required ☐ YES ☒ NO

☐ GRAVITY ☐ PRESSURE

☒ Residence No. Bedrooms 3

☐ Business No. Persons —

☐ Other No. Employees —

☐ Slab ☐ Crawl Space


☐ Basement w/plumbing ☒ Basement w/o plumbing

Water Supply: ☒ Private ☐ Public ☐ Community

Comments / Conditions
* New Garage is OK where located
* changed repair to LP PPBPS (50% reduced)

Comments / Conditions

INITIAL SITE SKETCH

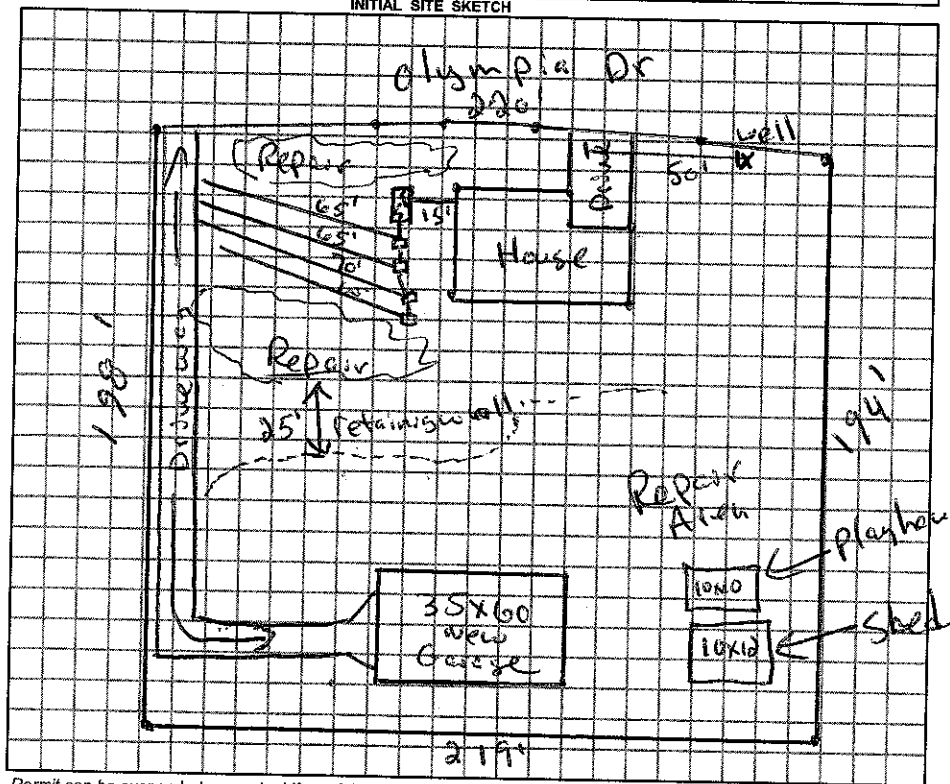

AS BUILT SKETCH

Permit can be suspended or revoked if any false information is supplied toward securing the permit / any unauthorized changes are made to the site / any unauthorized changes are made in the installation of the system.

☐ *IMPROVEMENT PERMIT w / plat valid without expiration.* ☐ *IMPROVEMENT PERMIT w / site plan valid for 60 mos.* ☐ *AUTHORIZATION TO CONSTRUCT valid for period equal to IMPROVEMENT PERMIT-not to exceed 60 mo.*

Owner / Applicant Signature: Dana Beckham Date 5-29-09

Improvement Permit by: — Date —

Authorzation to Construct by: — Date —

YOU SHOULD CONTACT A LOCATOR SERVICE PRIOR TO ANY EXCAVATION.

Installed by: Larry Beam

Operation Permit by: — Date: —

Existing System Inspected by: [signature] Date: 5/28/09

WHITE COPY Environmental Health YELLOW COPY (Final) Owner / Applicant PINK COPY (Initial) Owner / Applicant