IREDELL COUNTY HEALTH DEPARTMENT

STATESVILLE 704-878-5305 MOORESVILLE 704-664-5281

IMPROVEMENT PERMIT / AUTHORIZATION TO CONSTRUCT / OPERATION PERMIT / EXISTING SYSTEM INSPECTION

PERMIT# 119206 PIN# 4658-06-4112.82 DATE 12/16/04

OWNER OR CONTRACTOR Tony Hager PHONE: Business Home

ADDRESS 2345 Sloop Rd Mt Ulla 28125

LOCATION 21 N, TL Cornelius, TR Olympia on Rt 4 cross From Aleph Ln.

SUBDIVISION Cornelius Est. BLOCK / SECTION Lot # Changed LOT ~~#83~~ LOT AREA 1.076 ac SITE CLASS AS DESIGN FLOW 360 L.T.A.R. 0.35

Septic Tank: 1000 Gallons; STB 312 Date 11/9/04

Pump Tank: Gallons; PT Date

Pump Make: Model Serial No.

Nitrification Field: No Fields 1 Square Feet 780 Linear Feet 260

No Lines 4 Trench Width 36" Max Trench Bottom Depth 36" Gravel Depth —

☒ New System ☐ Repair System Type: I. II. III. IV. V. VI

System Description: Gravity 25% Reduction

Repair System Description: Same

Maintenance Agreement Required: ☐ Yes ☒ No

☒ House/Mod. Home No. Bedrooms 3

☐ Mobile Home No. Bathrooms

☐ Business No. Employees

☐ Other

☐ Slab ☐ Crawl Space ☐ Basement w/plumbing ☒ Basement wo/plumbing

Water Supply: ☒ Individual ☐ Public ☐ Community


Comments:/Conditions:

Comments:/Conditions:

Original Permit missing at Inspection - Copy Attached

~~INITIAL SITE SKETCH~~ As Built

Not to Scale

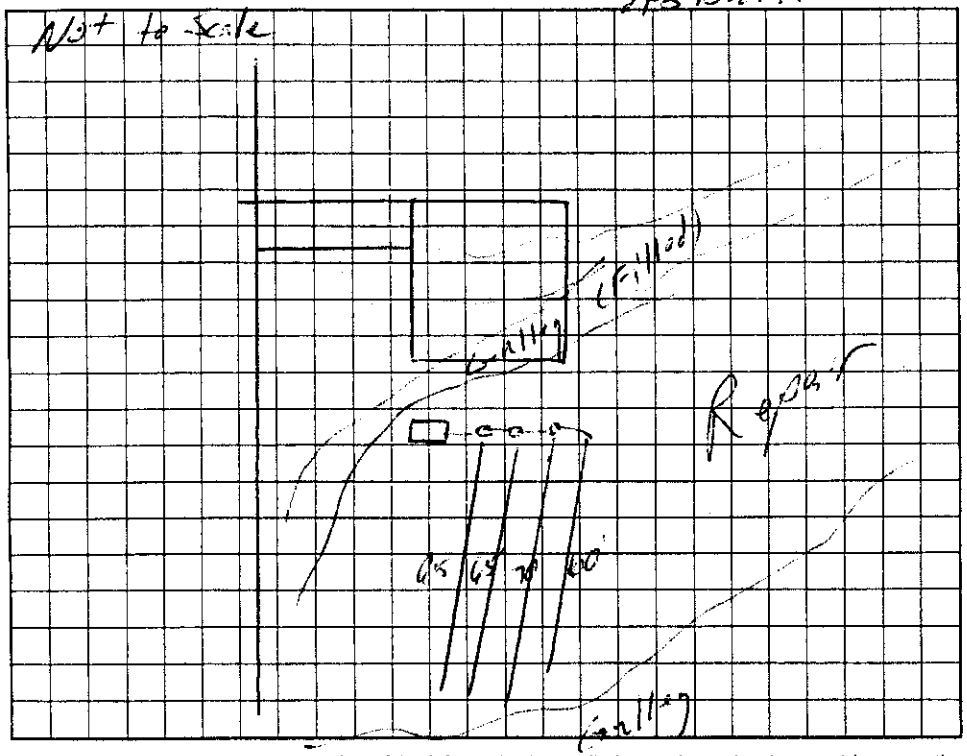

AS BUILT SKETCH

EZ Flow Installed

Permit can be suspended or revoked if any false information is supplied toward securing the permit/any unauthorized changes are made to the site/any unauthorized changes are made in the installation of the system. Improvement Permit with plat valid without expiration. Improvement Permit with site plan valid for sixty months. Authorization to Construct is valid for a period equal to that of Improvement Permit – not to exceed sixty months.

Signed: date

Improvement Permit by: RS date 12/14/04

Authorization to Construct by: RS date 12/16/04

Installed by: Larry Beam

Operation Permit by: RS date 12/16/04

Existing System Inspection by: date

HEALTH DEPT. COPY: WHITE OWNER COPY (FINAL): YELLOW OWNER COPY (INITIAL): PINK