IREDELL COUNTY HEALTH DEPARTMENT

STATESVILLE 704-878-5305 MOORESVILLE 704-664-5281

IMPROVEMENT PERMIT / AUTHORIZATION TO CONSTRUCT / OPERATION PERMIT / EXISTING SYSTEM INSPECTION

130.00

DATE 6/29/04

PERMIT# 119206 PIN# 4658-06-4112.82 PHONE: Business Home 704 663-2464

OWNER OR CONTRACTOR Tony Hager

ADDRESS 2345 Sloop Rd Mt. Ulla 28125

LOCATION 21 N, TL Cornelius, TR Olympia on Rt across From Alaqah SUBDIVISION Cornelius Est BLOCK / SECTION LOT 82 LOT AREA 1.006 Ac SITE CLASS PS DESIGN FLOW 360 L.T.A.R. 0.35

Septic Tank: 1000 Gallons: STB Date

Pump Tank: Gallons: PT Date

Pump Make: Model Serial No.

Nitrification Field: No Fields 1 Square Feet 771. Linear Feet 257'

No Lines 3 Trench Width 36" Max Trench Bottom Depth 36" Gravel Depth —

☒ New System ☐ Repair System Type: I, II, III, IV, V, VI

System Description: Gravity 25% Reduction

Repair System Description: Same

Maintenance Agreement Required: ☒ Yes ☐ No

☒ House/Mod. Home ☐ Mobile Home ☐ Business ☐ Other

No. Bedrooms 3 No. Bathrooms 2.5 No. Employees


Water Supply: ☒ Individual ☐ Public ☐ Community

☐ Slab ☐ Crawl Space ☐ Basement w/plumbing ☒ Basement wo/plumbing

Comments/Conditions: Drive can be on Either Side Olympia Rd R/W


Comments/Conditions: * Gulleys Need To be filled with Good Filled (No Trash) - All parts of Septic Needs To be 5' From Filled Gulleys

INITIAL SITE SKETCH

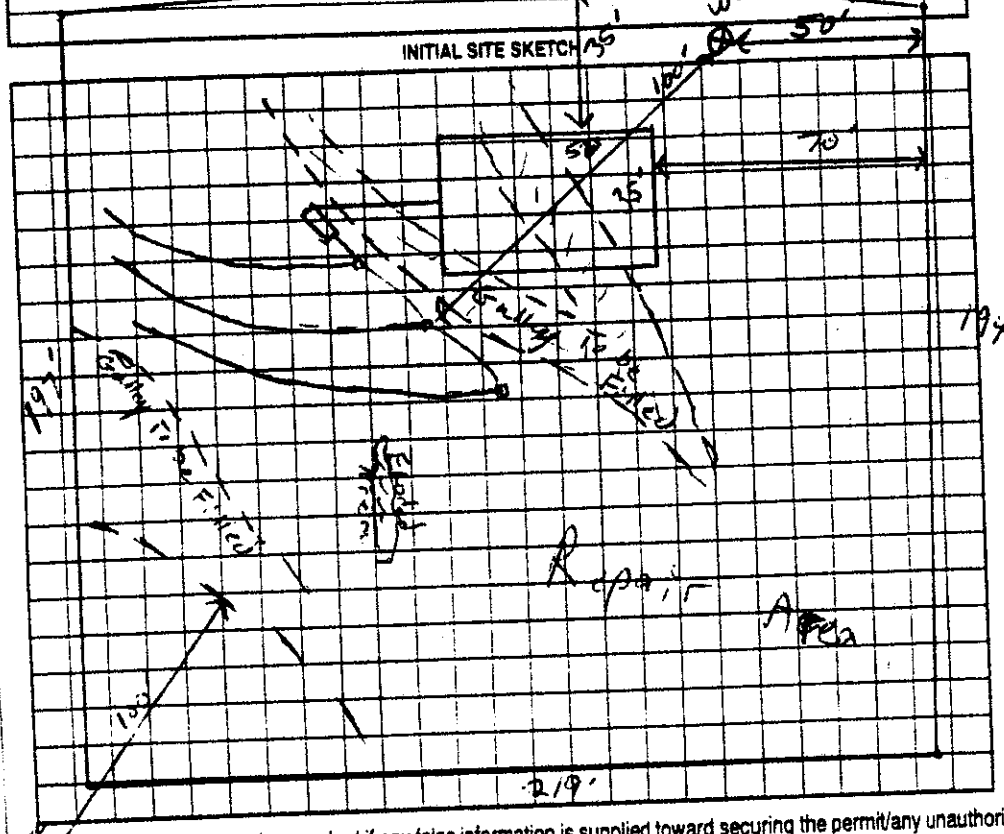

AS BUILT SKETCH

1"=50'

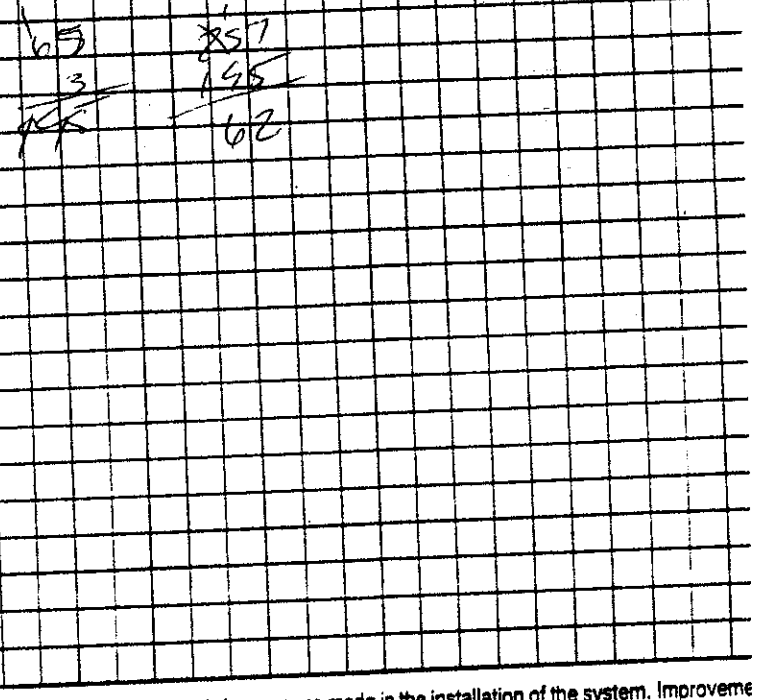

Permit can be suspended or revoked if any false information is supplied toward securing the permit/any unauthorized changes are made to the site/any unauthorized changes are made in the installation of the system. Improveme

Permit with plat valid without expiration. Improvement Permit with site plan valid for sixty months. Authorization to Construct is valid for a period equal to that of Improvement Permit – not to exceed sixty months.

Signed: date 7-1-04 Installed by: date

Improvement Permit by: date 6/29/04 Operation Permit by: date

Authorization to Construct by: date 6/29/04 Existing System Inspection by:

WHITE: DEPT COPY WHITE OWNER COPY (FINAL): YELLOW OWNER COPY (INITIAL): PINK