IREDELL COUNTY HEALTH DEPARTMENT

STATESVILLE 704-878-5305 130.00 Paid MOORESVILLE 704-664-5281

IMPROVEMENT PERMIT / AUTHORIZATION TO CONSTRUCT / OPERATION PERMIT / EXISTING SYSTEM INSPECTION

PERMIT# 124502 PIN# 4658 06 7606 DATE 11/30/04

OWNER OR CONTRACTOR Brandon C Phillips / EDWARD RUIZ PHONE: Business Home 704-227-9060

ADDRESS 18817 Nautical Drive 28031

LOCATION Cornelius, NC. 28031 Cornelius Rd TR. on Olympia Dr. down 1.2 on (R) B4 Bailey Rd.

SUBDIVISION Cornelius Estates BLOCK / SECTION LOT 64 LOT AREA 1.5 SITE CLASS: PS DESIGN FLOW 480 L.T.A.R. .31

Septic Tank: 1000 Gallons; STB 760 Date 8/9/05

Pump Tank: 1000 Gallons; PT 363 Date 11/24/05

Pump Make: ZOELLER Model N-152 Serial No.

Nitrification Field: No Fields 1 Square Feet 1200 Linear Feet 400

No Lines 5@80' Trench Width 3 Max Trench Bottom Depth 3 Gravel Depth No

[X] New System [ ] Repair System Type: I, II, III, IV, V, VI

System Description: PM - 25% Reduced

Repair System Description: Same

Maintenance Agreement Required: [ ] Yes [X] No

[X] House/Mod. Home [ ] Mobile Home [ ] Business [ ] Other

No. Bedrooms 4 No. Bathrooms 2 No. Employees


[X] Slab [ ] Crawl Space [X] Basement w/plumbing [X] Basement wo/plumbing

Water Supply: [X] Individual [ ] Public [ ] Community


Comments:/Conditions:

Comments:/Conditions:

INITIAL SITE SKETCH

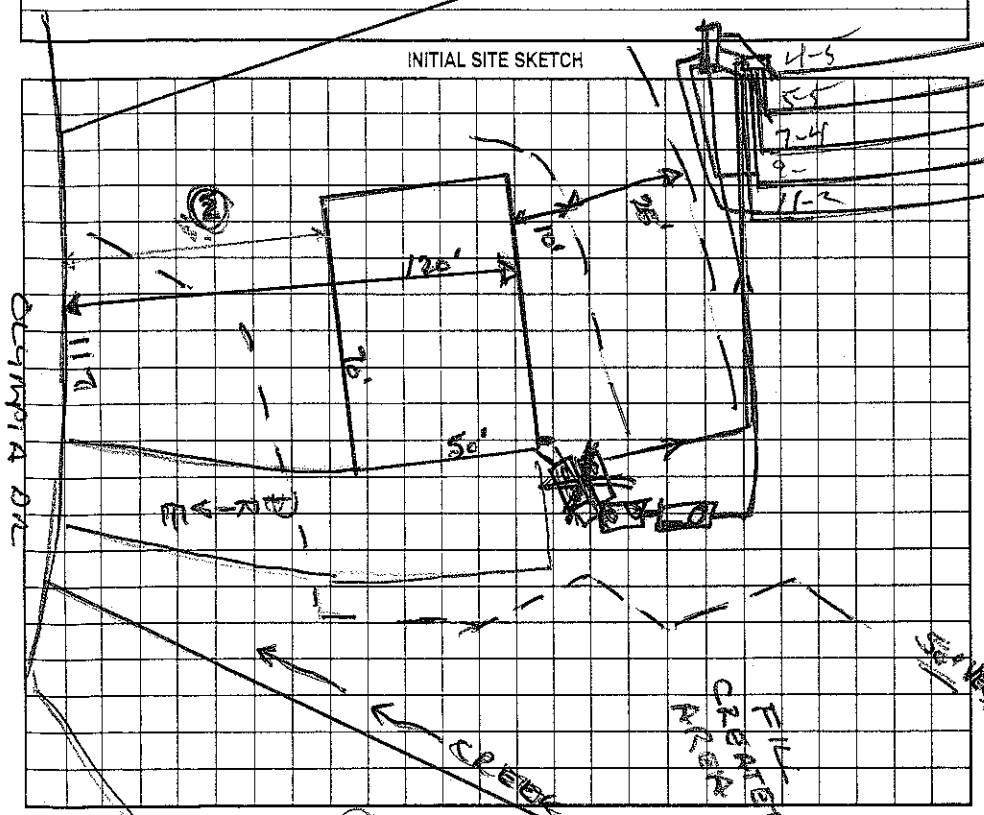

AS BUILT SKETCH

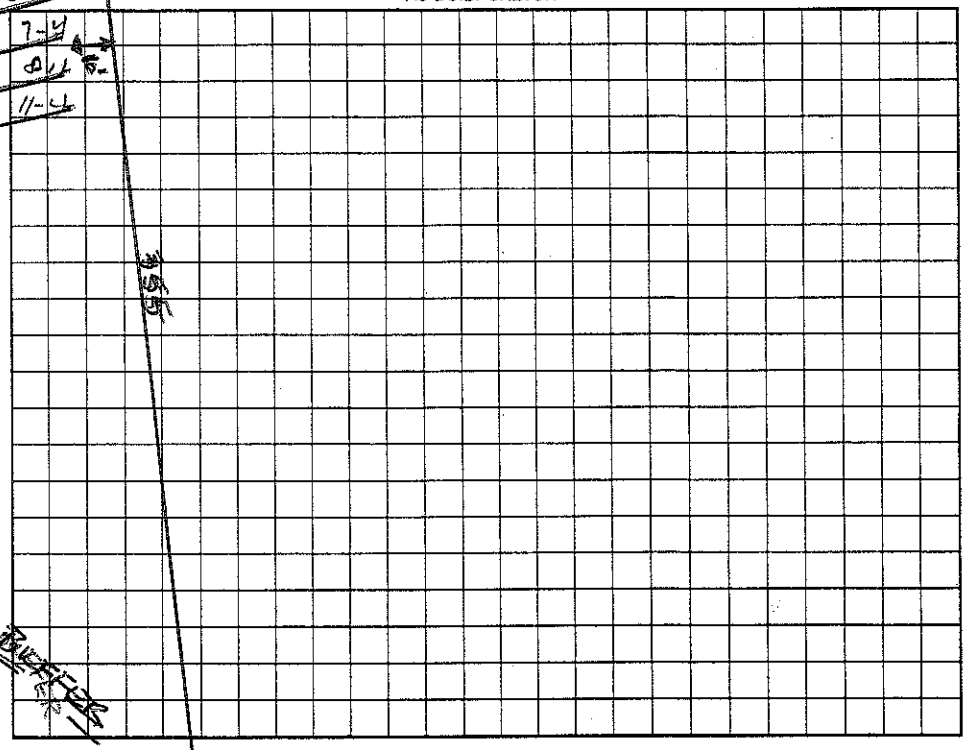

Permit can be suspended or revoked if any false information is supplied toward securing the permit/any unauthorized changes are made to the site/any unauthorized changes are made in the installation of the system. Improvement Permit with plat valid without expiration. Improvement Permit with site plan valid for sixty months. Authorization to Construct is valid for a period equal to that of Improvement Permit – not to exceed sixty months.

Signed: X BCP 340 date 11/3/04 Installed by: Wolfpack Septic Tank

Improvement Permit by: Wesley Sparks RS date 11/30/04 Operation Permit by: Wesley Sparks RS. date 6/28/06

Authorization to Construct by: Wesley Sparks RS date 11/30/04 Existing System Inspection by: date

HEALTH DEPT. COPY: WHITE OWNER COPY (FINAL): YELLOW OWNER COPY (INITIAL): PINK