IREDELL COUNTY HEALTH DEPARTMENT

STATESVILLE 704-878-5305 130.00 MOORESVILLE 704-664-5281

IMPROVEMENT PERMIT / AUTHORIZATION TO CONSTRUCT / OPERATION PERMIT / EXISTING SYSTEM INSPECTION

PERMIT# 125172 PIN# ~~4658-06-7843~~ 4658067842 DATE 11/3/05

OWNER OR CONTRACTOR Breeden Phillips PHONE: Business 704-309-4424 Home

ADDRESS 18817 Nautical Dr Cornelius NC 28031

LOCATION 2N, TL Cornelius, TR Olympia on Rt.

SUBDIVISION Cornelius Est BLOCK / SECTION LOT 67 LOT AREA 0.682AC SITE CLASS PS DESIGN FLOW 360 L.T.A.R. 0.3

Septic Tank: 1000 Gallons; STB 321 Date 5/17/05
Pump Tank: 1000 Gallons; PT 40 Date 5/6/05
Pump Make: Zoeller Model N137-C Serial No.
Nitrification Field: No Fields 1 Square Feet 1200 Linear Feet 400
No Lines 5@80' Trench Width 36" Max Trench Bottom Depth 36" Gravel Depth 12"

☒ New System ☐ Repair System Type: I, II, III, IV, V, VI
System Description: Pump Conventional
Repair System Description: Pump 25% Reduct.
Maintenance Agreement Required: ☐ Yes ☒ No

☒ House/Mod. Home No. Bedrooms 3
☐ Mobile Home No. Bathrooms
☐ Business No. Employees
☐ Other


☒ Slab ☒ Crawl Space ☐ Basement w/plumbing ☐ Basement wo/plumbing

Water Supply: ☒ Individual ☐ Public ☐ Community

Comments:/Conditions:

1"=50'


INITIAL SITE SKETCH

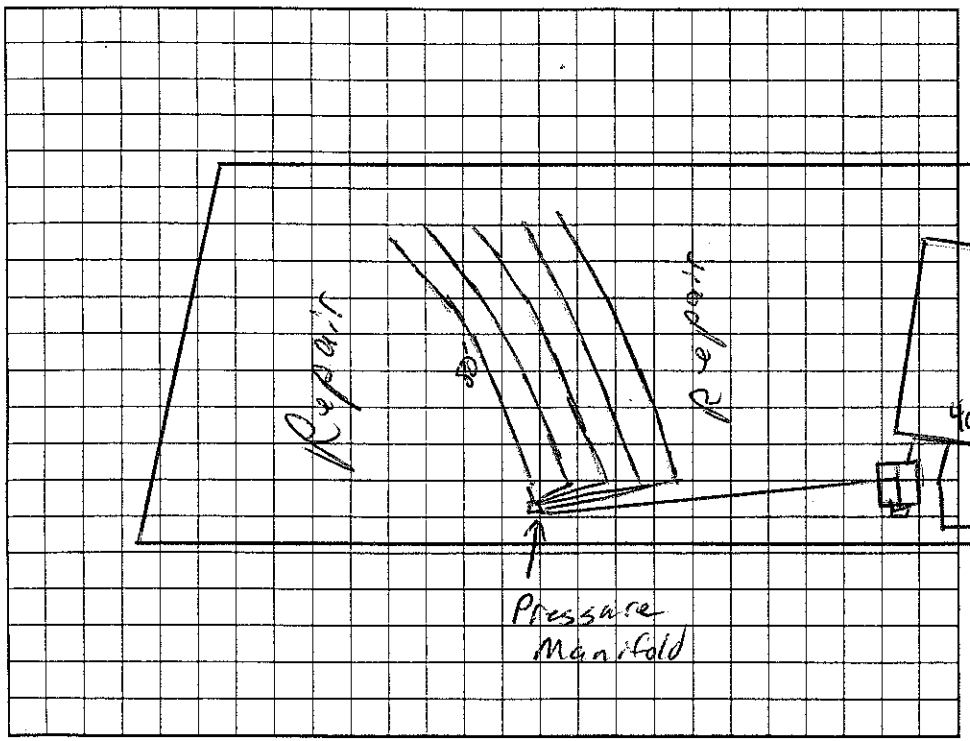

Comments:/Conditions:

It appears as though tanks & lines were ~~checked on~~ 6/24/05 by Gary McNelly but ICC was never called backed for Final Inspection

AS BUILT SKETCH

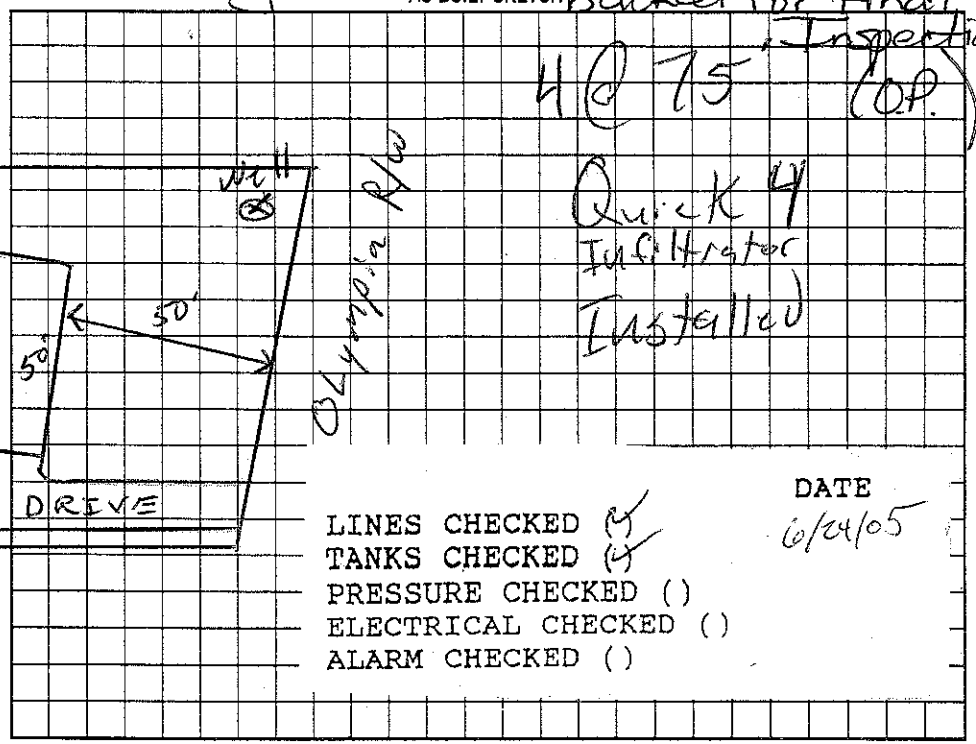

DATE 6/24/05

LINES CHECKED (Y)
TANKS CHECKED (Y)
PRESSURE CHECKED ( )
ELECTRICAL CHECKED ( )
ALARM CHECKED ( )

Permit can be suspended or revoked if any false information is supplied toward securing the permit/any unauthorized changes are made to the site/any unauthorized changes are made in the installation of the system. Improvement Permit with plat valid without expiration. Improvement Permit with site plan valid for sixty months. Authorization to Construct is valid for a period equal to that of Improvement Permit – not to exceed sixty months.

Signed: BM date 11/13/05 Installed by: G+M

Improvement Permit by: RS date 11/12/05 Operation Permit by: date

Authorization to Construct by: date 5/9/05 Existing System Inspection by: date

HEALTH DEPT. COPY: WHITE OWNER COPY (FINAL): YELLOW OWNER COPY (INITIAL): PINK